

Name **Joseph Dufour**

Service No. 12

Address **611 Mass. Avenue**

Lexington, Mass.

Location **611 Mass. Avenue**

Kind of Pipe

Size

Size of Main

~~XXXXXXXXXX~~ New Service

Com. 7-3-50

Location

Date	Material	Amount	Total	Date	Amount
May 22, '50	Labor	74 75	74 75	April 29 '50	150 00
	10% Overhead		7 48	July 20 '50	5 63
	46' - 6" Sewer Pipe @.28		12 88		144 37
	Joint Compound		2 76	May 23, '50	No Charge
	Littlefield Shovel 5 hrs. @7.00	35 00	35 00	Labor	21 47
	Trucking 2 hrs. @.75		1 50	8' - 6" Sewer Pipe @.28	2 24
	Patching 10 x 3		10 00	Joint Compound	48
			144 37	Littlefield Shovel 3hrs @7.00	21 00
				Trucking 1 hr. @.75	75
				Patching 8 x 3	8 00
					53 94
	Labor				

TOWN OF LEXINGTON—DEPT. OF PUBLIC WORKS
SEWER DIVISION

DATE

NO.


The undersigned applies for the construction of a particular sewer connecting No.
Street and hereby agrees to comply with the Rules and Regulations governing the construction **and use of Particular**
Sewers, as now or at any future time established by the Board of Selectmen.

Am't of estimate \$.....

Am't Paid \$.....

..... Owner

Sketch of Service Here

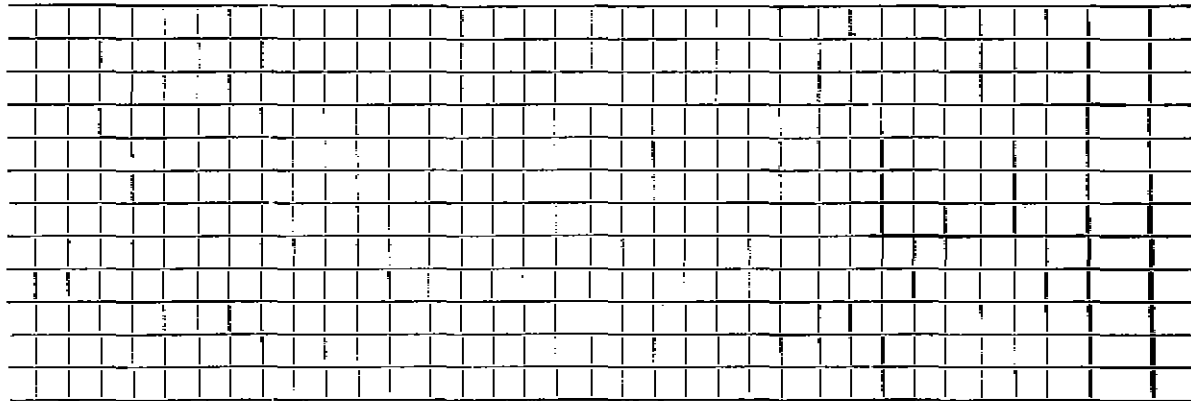

Connection made in Street.

Work completed 19..

Remarks: