

Books to file

Address Stearns Street

678 Mass. Ave.

Location Cor. Mass. Ave. & Pleasant St.

678 Mass Ave

Kind of Pipe

Size

Size of Main

Repaired - New Service

Location

Date	Material	Amount	Total	Date	Amount
8/7-31-24	50*6" Sewer Pipe @.30	15 00			
9-5-13	1 Bend	70		Aug 19 1930 - Check	30 13
9-23-31	Sulphur & Jute	2 00		Sept 9 1930 - Cash	65 -
30-13	Trucking	3 25	20 95		
7/2/28	114 hrs. Labor @.55	62 70			
	3 " " @.60	1 80	64 50		
	15% Overhead		9 68		
			95 13		
	Labor				

TOWN OF LEXINGTON—BOARD OF PUBLIC WORKS  
**SEWER DIVISION**

DATE \_\_\_\_\_

NO. \_\_\_\_\_


The undersigned applies for the construction of a particular sewer connecting No. \_\_\_\_\_  
Street and hereby agrees to comply with the Rules and Regulations governing the construction and use of Particular  
Sewers, as now or at any future time established by the Board of Selectmen.

Am't. of Estimate \$ \_\_\_\_\_

Am't. Paid \$ \_\_\_\_\_

\_\_\_\_\_  
Owner

Sketch of Service Here

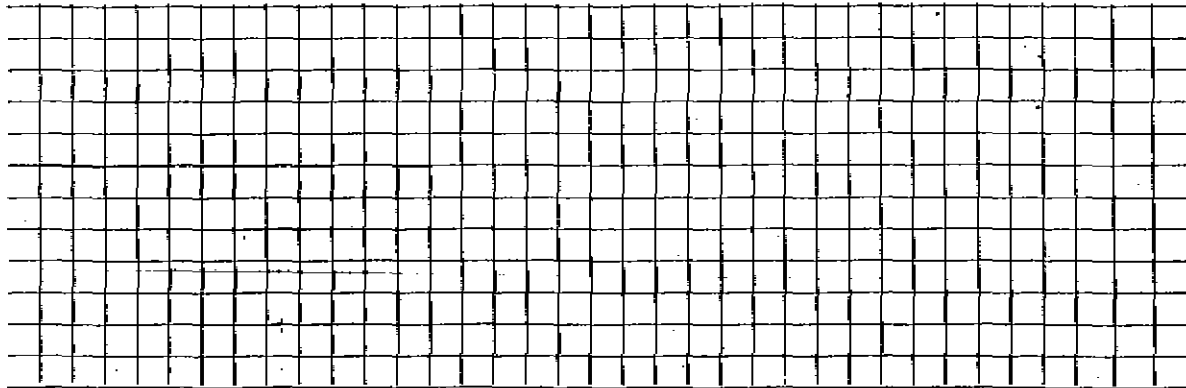

Connection made in \_\_\_\_\_ Street. Work completed \_\_\_\_\_ 19

Remarks: