

Address

Harvard, Mass.

703/705 Mass Ave

Location 703/705 Mass. Ave.

Kind of Pipe

Size

Size of Main

~~NEW SERVICE~~ New Service

Location

Date	Material	Amount	Total	Date	Amount
	42 6" Sewer Pipe @.25	12 25			
	10 1/4" Iron Pipe @.50	5 00			
	Sulphur & Jute	1 96			
	Trucking	1 75	20 96		
11/14/31	90 Hrs. Labor @.55	49 50			
7 "	" @.60	4 20	53 70		
	100' Overhead		8 06		
	Compressor 2 1/2 Hrs. @.2.50		11 25		
			93 97		
	Return Labor		6 03		
			\$100 00		
				1-27-33	50 - Copied

TOWN OF LEXINGTON—BOARD OF PUBLIC WORKS  
SEWER DIVISION

DATE \_\_\_\_\_

NO. \_\_\_\_\_


The undersigned applies for the construction of a particular sewer connecting No. \_\_\_\_\_  
Street and hereby agrees to comply with the Rules and Regulations governing the construction and use of Particular  
Sewers, as now or at any future time established by the Board of Selectmen.

Am't. of Estimate \$ \_\_\_\_\_

Am't. Paid \$ \_\_\_\_\_

\_\_\_\_\_  
Owner

Sketch of Service Here

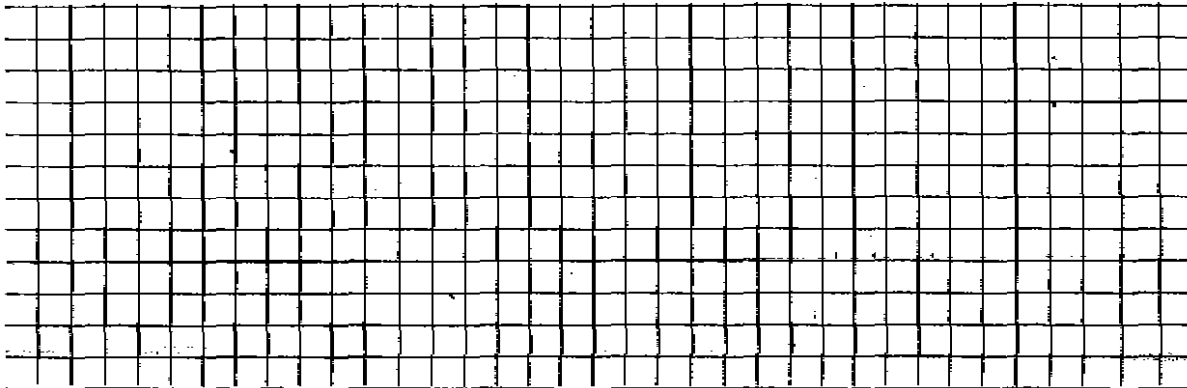

Connection made in \_\_\_\_\_ Street.

Work completed \_\_\_\_\_ 19

Remarks: