


DATE _____

TOWN OF LEXINGTON — BOARD OF PUBLIC WORKS
SEWER DIVISION

Sketch of Service Here

735

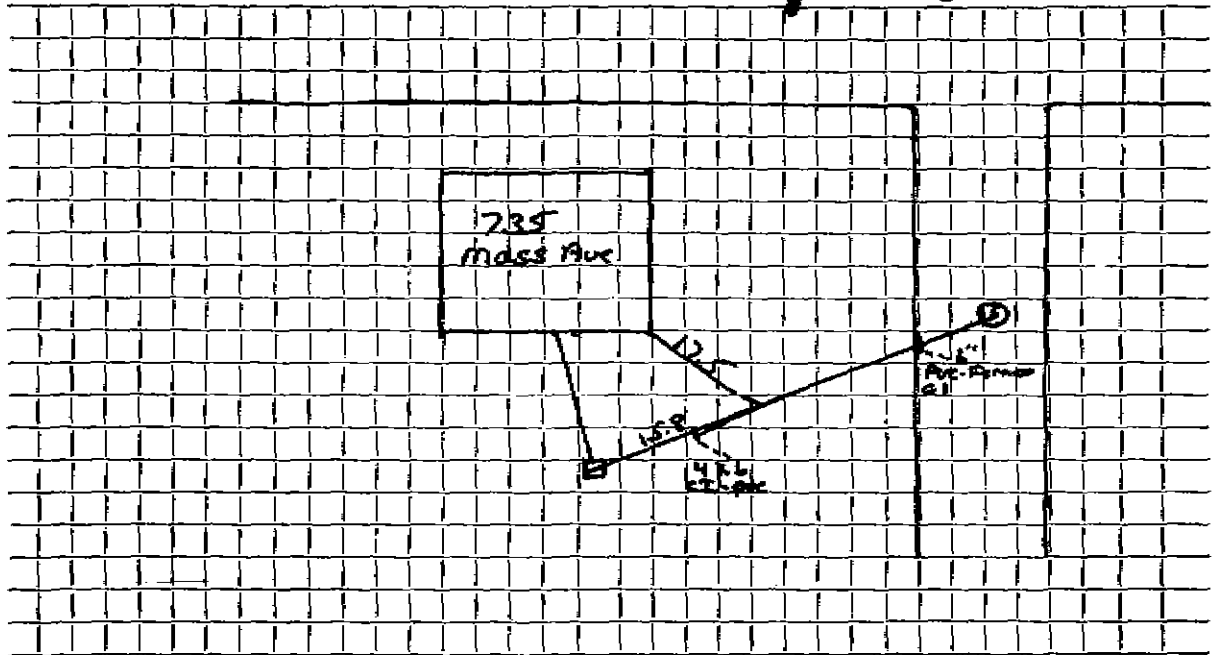

Connection made in Street. Work completed 8:24:94

Remarks: PVC Clean out.... 42.6. From Manhole. In Street.... 15.8. From Cement clean out
Behind Library..... PVC Cap marked by Curb rod.... 4" Below ground level/.....