

Address

100 Mass. Avenue

Location 208 Mass. Ave

Kind of Pipe

Size

Size of Main

Expense Statement - New Service

Date	Material	Amount	Total	Date	Location	Amount
8/9-18-24	46" 4" Sewer Pipe @ .20	9 20				
8/1-23	10" 4" Iron Pipe @ .50	5 00		July 21 1925 - Cash		25 00
	1 1" Band	70		Oct 15 1925 - Cash		56 42
	Trucking	75				81 23
	4 Stick Dym @ .50	25				
	1 Cap	12				
	Sulphur & Juts	<u>1 86</u>	17 86			
8/25/28	96 Hrs. Labor @ .55	53 20				
	2 " " @ .60	<u>1 20</u>	55 10			
	15% Overhead		<u>8 27</u>			
	Labor		81 23			

TOWN OF LEXINGTON—BOARD OF PUBLIC WORKS
SEWER DIVISION

DATE _____

NO. _____


The undersigned applies for the construction of a particular sewer connecting No. _____
Street and hereby agrees to comply with the Rules and Regulations governing the construction and use of Particular
Sewers, as now or at any future time established by the Board of Selectmen.

Am't. of Estimate \$ _____

Am't. Paid \$ _____

Owner

Sketch of Service Here

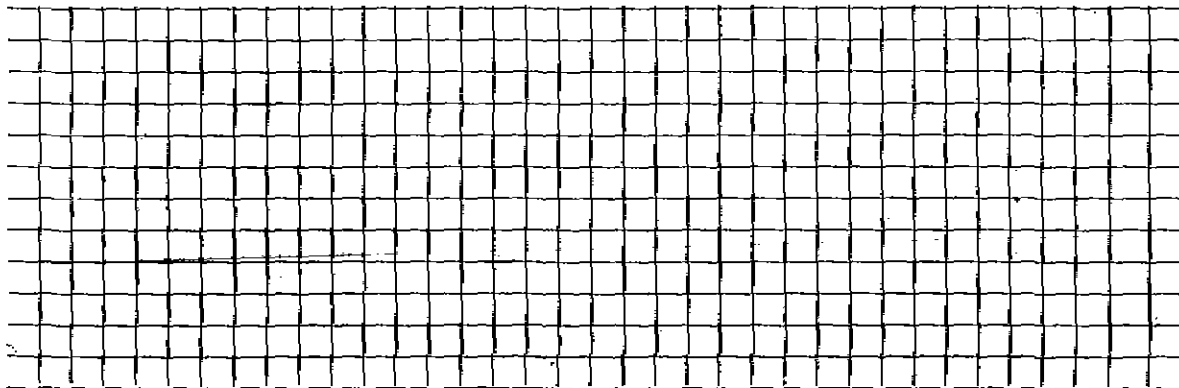

Connection made in _____ Street.

Work completed _____ 19

Remarks: