


DATE Oct 17, 2001

TOWN OF LEXINGTON — BOARD OF PUBLIC WORKS
SEWER DIVISION

Sketch of Service Here

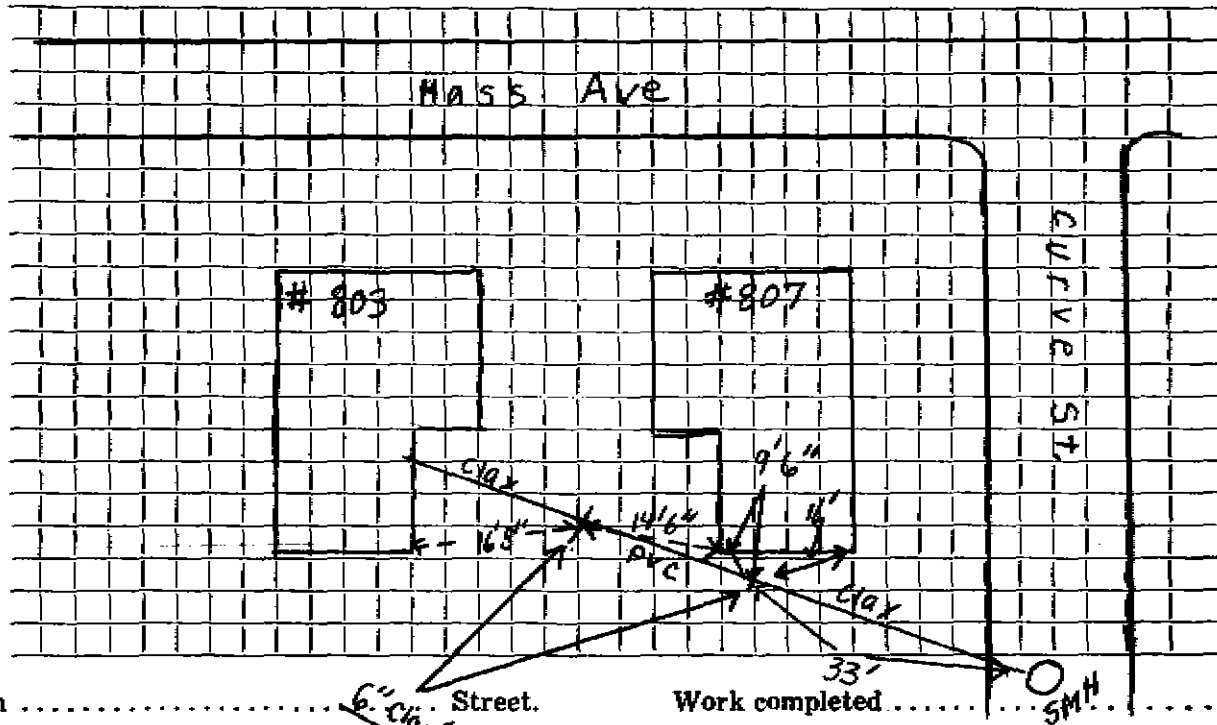

Connection made in Street. Work completed SMH

Remarks: *PVC Renewal*
15.3'6" deep
22'-6" PVC Ferrado Ferro