

Name

Service No.

Address

812 Mass Ave

Location

Kind of Pipe

SDR Sch. 35 PVC

Size

6"

Size of Main

Repair—Renewal

New Service

Location

Date

Material

Amount

Total

Date

Amount

9/21/21

SMH w/
concrete trap

ferroc to
existing 6" clay
(lined)

45° bend w/
6" cleanout


2-11° Bend

DATE 9/21/21

TOWN OF LEXINGTON — BOARD OF PUBLIC WORKS

SEWER DIVISION

Sketch of Service Here

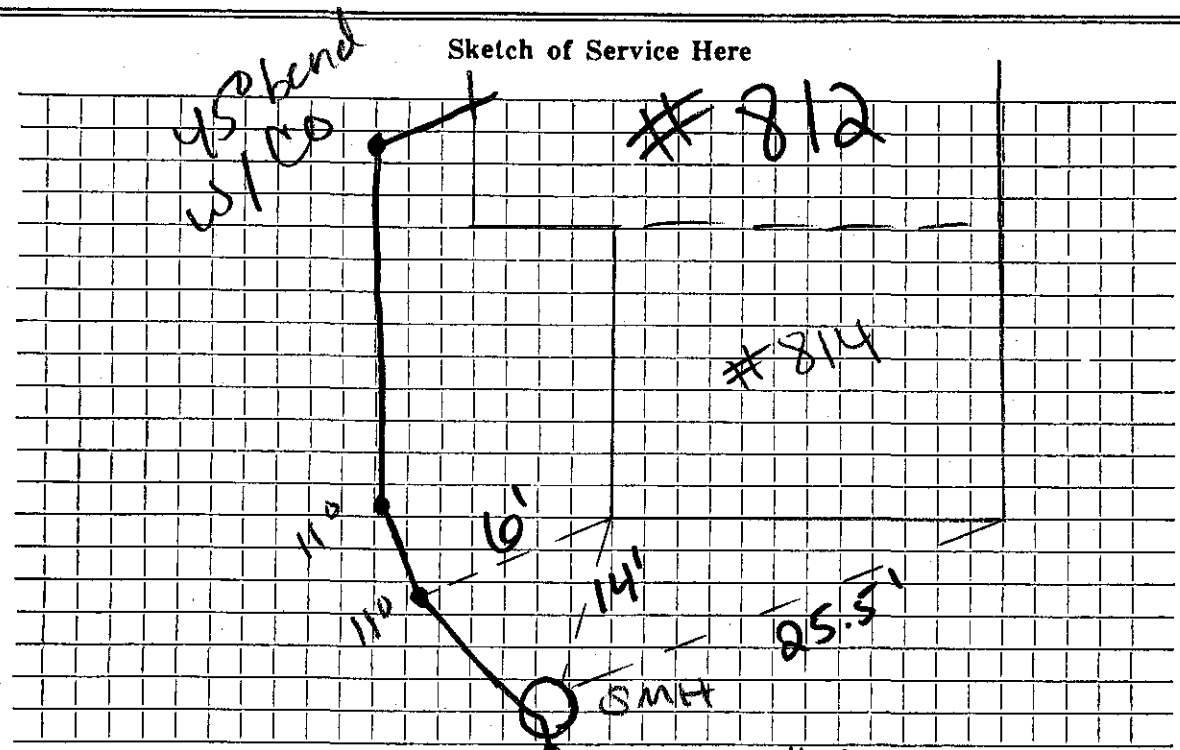

Connection made in Mass Ave Street. Work completed existing 6" clay service (lined)

Remarks:

.....

.....