

Serial No. 100

Address 200 Hill Avenue

821 + 823 Mass. Ave. Boston, Mass.

Kind of Pipe \_\_\_\_\_ Size \_\_\_\_\_ Size of Main \_\_\_\_\_ Location \_\_\_\_\_

~~Water~~ - New Service

Date	Material	Amount	Total	Date	Amount
7-12-28 for 5/1/02	30" 14" Sewer Pipe @ .20	6 00		July 18 1928 - Cook	54 02
	Sulphur & Jute	1 20			
	Trucking	75			
	1 4" Bend	70	8 65		
8/29/28	83 Hrs. Labor @ .55	34 65			
	8 " " @ .60	4 80	39 45		
	15% Overhead		5 92		
			54 02		
	Labor			1-18-65	Roots

TOWN OF LEXINGTON—BOARD OF PUBLIC WORKS

SEWER DIVISION

DATE

May 18-28

181

NO.

The undersigned applies for the construction of a particular sewer connecting No. 179 Mass Ave. Street and hereby agrees to comply with the Rules and Regulations governing the construction and use of Particular Sewers, as now or at any future time established by the Board of Selectmen.

Am't. of Estimate \$ \_\_\_\_\_


Am't. Paid \$ \_\_\_\_\_

2 Family House

C. S. Spaulding Owner

Sketch of Service Here

821 + 823

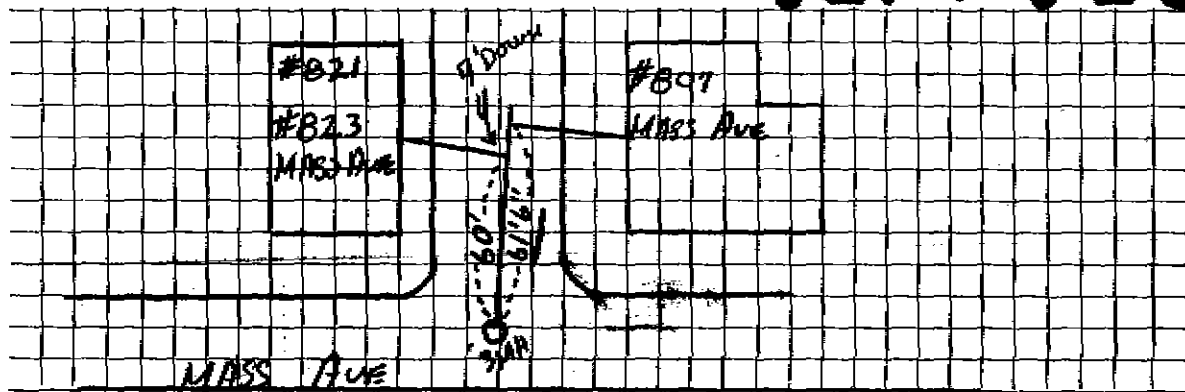

Connection made in \_\_\_\_\_ Street.

Work completed \_\_\_\_\_ 19

Remarks: