


DATE _____

TOWN OF LEXINGTON — BOARD OF PUBLIC WORKS

SEWER DIVISION

Sketch of Service Here

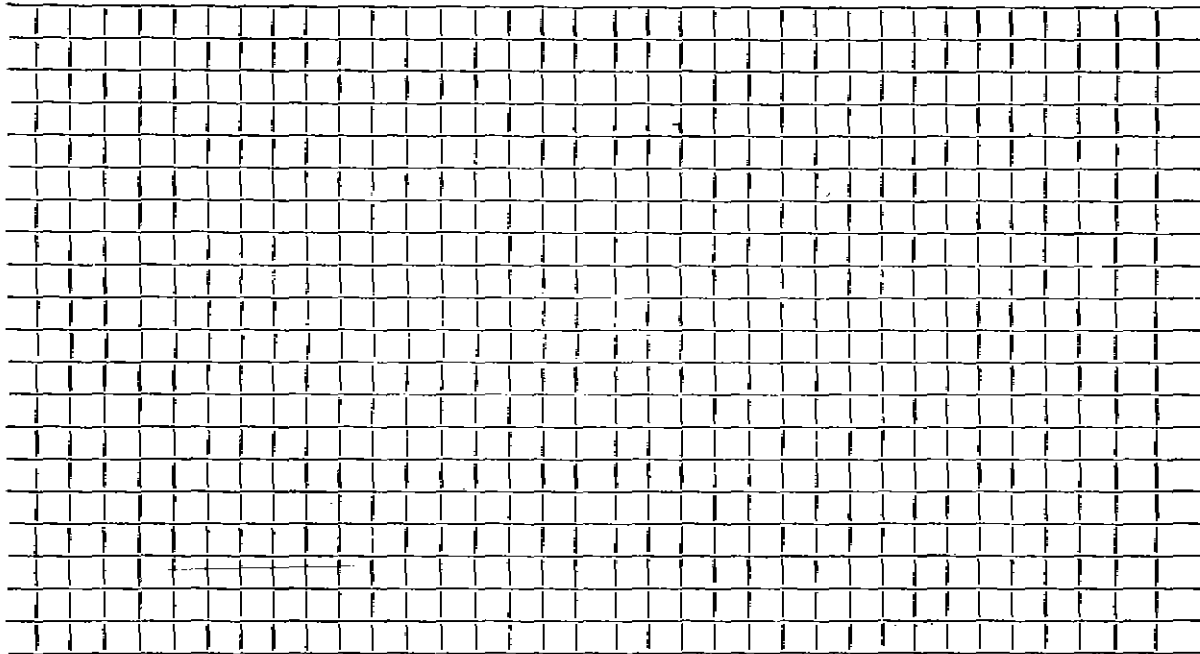

Connection made in Street. Work completed

Remarks: *1st front part of house needs new service connect. to new 6" PVC. with saddle to void this service.*


TOWN OF LEXINGTON — BOARD OF PUBLIC WORKS

SEWER DIVISION

DATE

Sketch of Service Here

822A

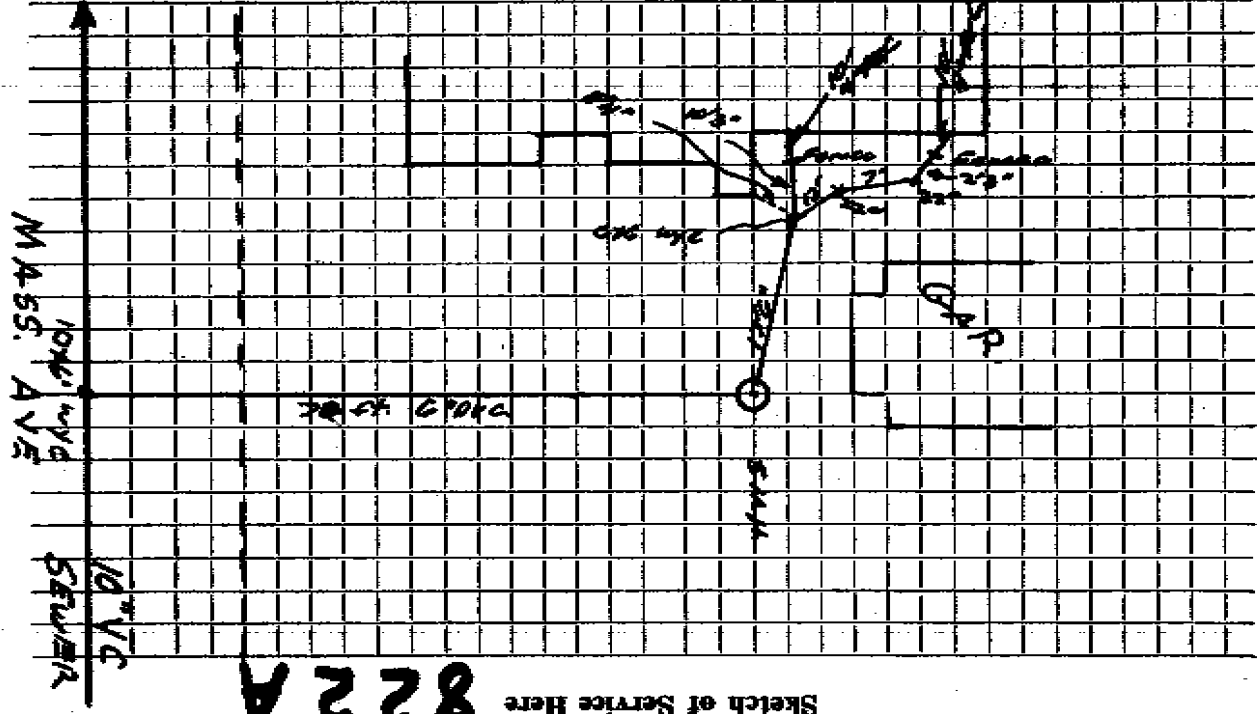


MASS. AVE

10" VC
SEWER

20' OF C.P.C.

5' VC

CP

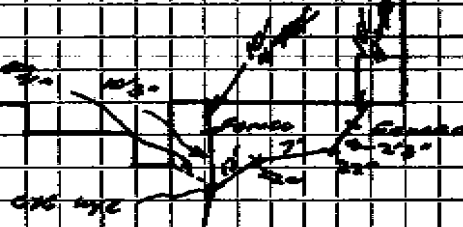

Work completed

Street

Connection made in

Remarks: 15' from north end of horse heads now service connect to C.P.C. with saddle found and service

