

Service No. 49605

Michael R. McCarty

Address 840 Mass. Ave.

840 Mass. Ave. Location 840 Mass. Ave.

Kind of Pipe Size of Main

~~NEW SERVICE~~ New Service Location

Date	Material	Amount	Total	Date	Amount
8/7-12-28	43 1/2" Sewer Pipe @.30	12.90			
8/25-29	6" Bend	70		June 30 1925 - Cash	25.00
8/25-29	Sulphur & Jute	1.72		June 27 1922 - Cash	1.50
8/25-29	Trucking	75	16.07	Aug 27-1929 - Cash	32.99
8/17/28	63 Hrs. Labor @.55	34.65		Apr 15-15-28	72.99
	3 " @.60	1.80	36.45	Apr 5-13-29	15.00
	15% Overhead		5.47	Ret. by Collector	57.99
	Labor		57.99		

TOWN OF LEXINGTON—BOARD OF PUBLIC WORKS

SEWER DIVISION

DATE June 30, 1928

NO. _____


The undersigned applies for the construction of a particular sewer connecting No. 184 Mass. Ave Street and hereby agrees to comply with the Rules and Regulations governing the construction and use of Particular Sewers, as now or at any future time established by the Board of Selectmen.

Am't. of Estimate \$ _____

Am't. Paid \$ 25.⁰⁰

Michael V. W. Conroy Owner

Sketch of Service Here

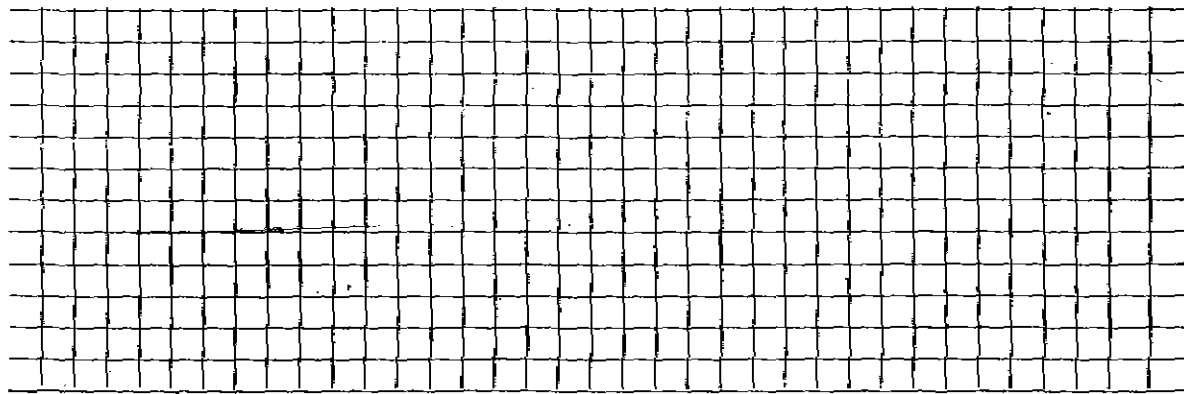

Connection made in _____ Street.

Work completed _____ 19

Remarks: