

Name Robert Tillinghast

Service No. 91

Address 861 Mass. Avenue

Lot A

Location

Kind of Pipe

Size 6"

Size of Main 10"

Repair—Renewal—New Service W.O.#5220 Gately #722

Location MAR 18 1968

Date	Material	Amount	Total	Date	Amount
3-67	28' 6" Transite pipe			8-1-67	150 00
	10' 4" Cast Iron pipe			3-18-68	13 69
				1-21-70	36 67
1/67	Labor	101.76			200 36
3/67	"	22.45	124 21	8-23-67	
	10% O.H.	12 42	136 63	18' 6" Transite	
18	6" Transite pipe @ 2.88		15 84	1 6" X 10" Wye	
3	bag cement @ 1.55		39		
2	ton cold patch @ 5.00		10 00		
3 1/2	hrs. trucking @ 3.00		10 50		
2	hrs. shovel @ 6.50		13 00		
2	hrs. compressor @ 5.00		10 00		
1	hr. loader @ 4.00		4 00		
			200 36		

Bill sent to 27


DATE _____

TOWN OF LEXINGTON — BOARD OF PUBLIC WORKS

SEWER DIVISION

Sketch of Service Here

861

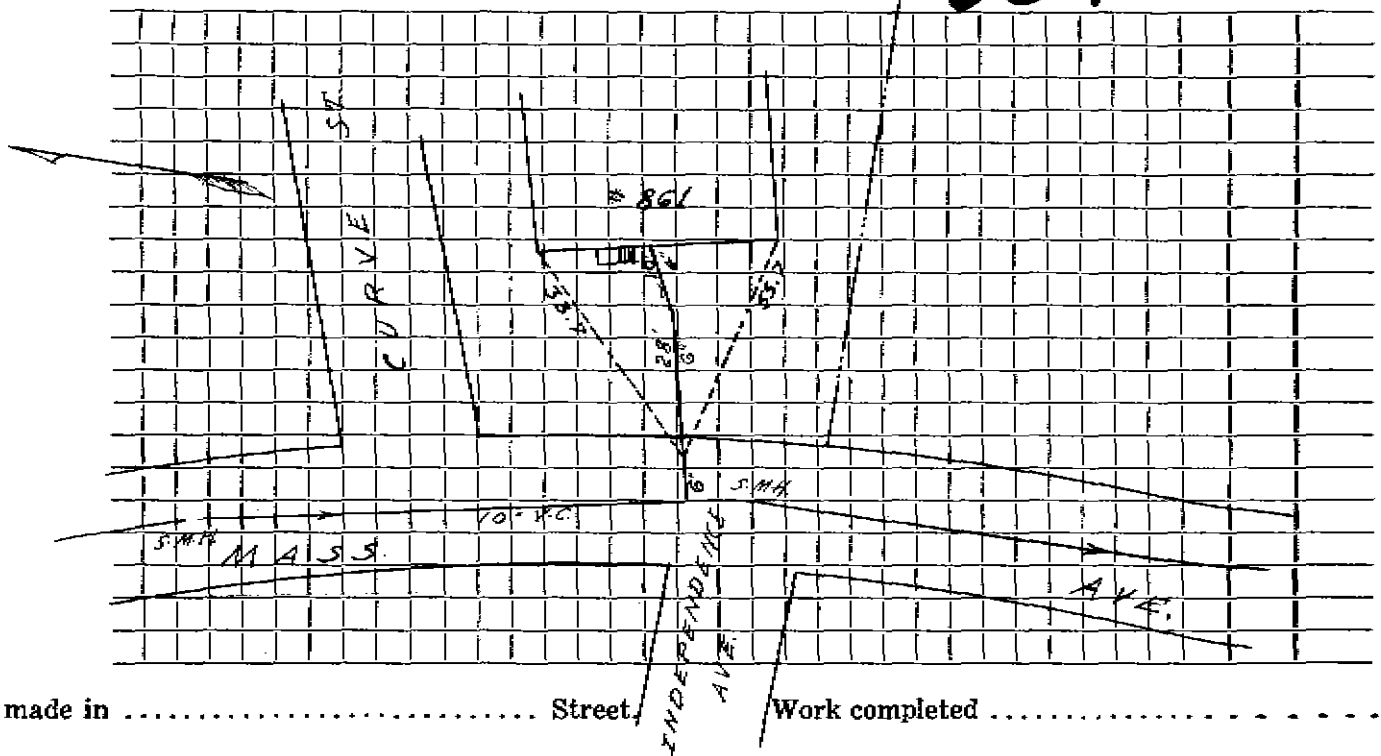

Connection made in Street, Work completed

Remarks:

.....

.....