

Name: Ralph Fynn

Service No.

Address 881 Mass. Avenue

881 Mass. Ave.

Location

Kind of Pipe

Size

Size of Main

Repair ~~By~~ ~~Contractor~~ Dave Eagle #3659

Location

Date		Material	Amount	Total	Date		Amount
6/19/81	57'	6" P.V.C.					
	3	6" x 22 $\frac{1}{2}$ " Elbow					
						OUTSIDE	
					6/19/81	19' 6" A.C. Pipe	
					6/26/81	2 5' 6" Transite (W.O.#1721)	
						1 10' 6" Transite	
						1 Fernco Adapter 6"	
						12 Bricks	
						$\frac{1}{2}$ Bag Cement	
						100 lbs. Sand	
						4 yds. Crushed Stone	
						Patch 18' x 10'	
						4 hrs. Trucking	
						3 hrs. Town Shovel	
						1 hr. Roller	


DATE

TOWN OF LEXINGTON — BOARD OF PUBLIC WORKS

SEWER DIVISION

Sketch of Service Here

881 + 883

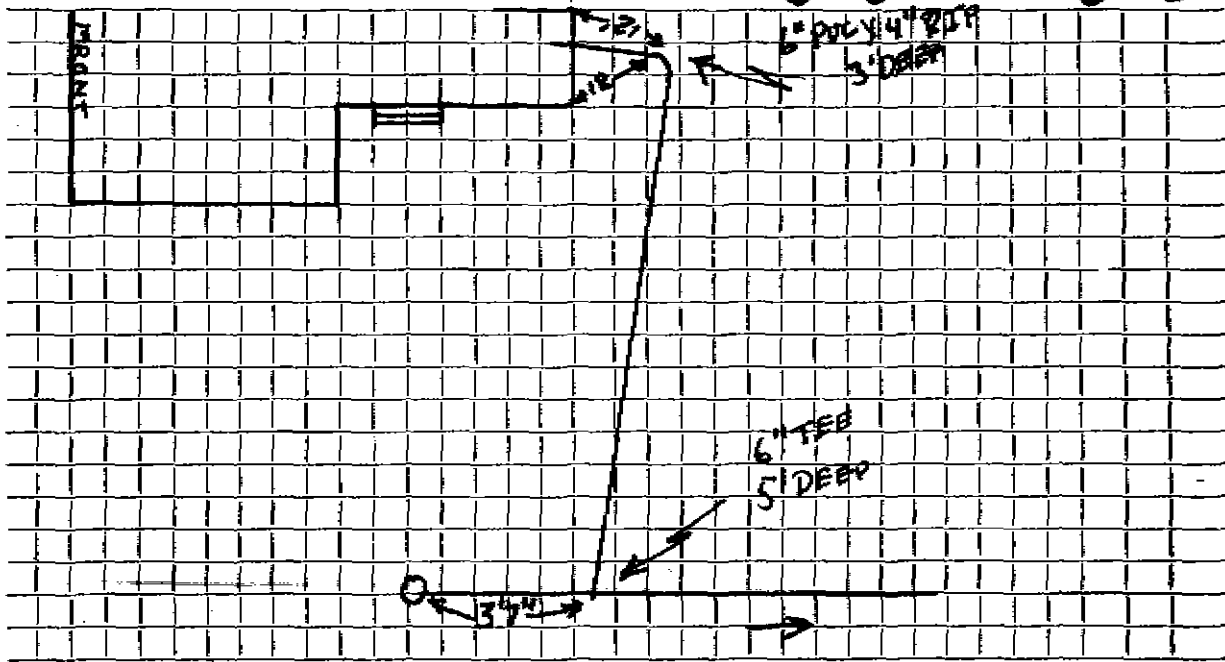

Connection made in CURVE ST Street. Work completed 6-19-81

Remarks: Original Service 1-23-29