

Name

Service No.

Address 881 Massachusetts Avenue

884 + 886 Mass. Ave.

Location

Kind of Pipe

Size

Size of Main

Repair—Renewal—New Service

Location

Date	Material	Amount	Total	Date	Amount
6-15-27	40' 4" Clay Pipe				
	1 6" X 1/2" Band				
	1 6" X 4" Reducer				
					NON CHARGE
				8/6/57	Labor 170 97
				20' 6"	Transite @ .702 14 04
				1 6" 11 1/2"	Transite Elbow 2 24
				1 6" 45°	Elbow 2 79
				1 6" V.C.	Elbow 1 88
				25 x 3	Patch 25 00
				3 Hrs	Town Chovel @ 6.50 19 50
				3 Hrs.	Trucking @ .75 2 25
	Labor				238 67

**TOWN OF LEXINGTON—DEPT. OF PUBLIC WORKS
SEWER DIVISION**

DATE.....

NO.


The undersigned applies for the construction of a particular sewer connecting No.....
Street and hereby agrees to comply with the Rules and Regulations governing the construction and use of Particular
Sewers, as now or at any future time established by the Board of Selectmen.

Am't of estimate \$.....

Am't Paid \$.....

..... Owner

Sketch of Service Here

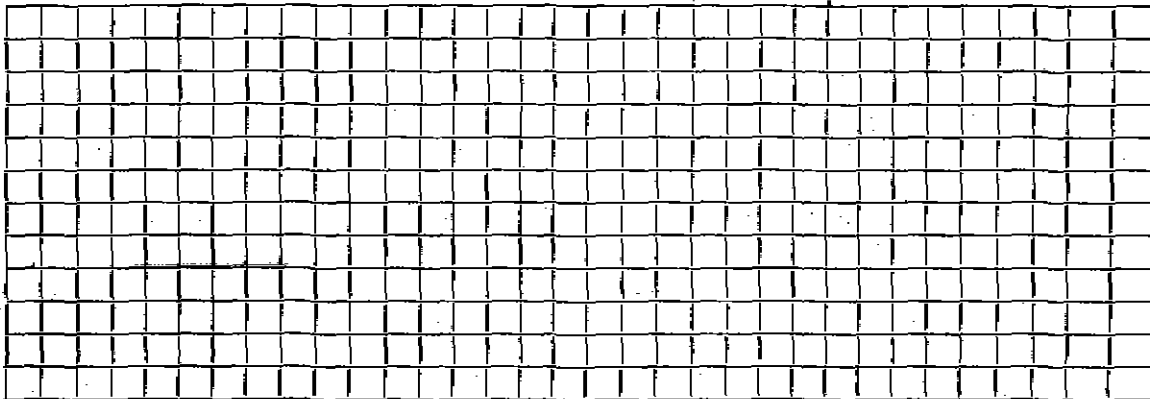

Connection made in..... Street.

Work completed..... 19..

Remarks: