

Name Alexander Traill

Service No. 132

Address 905 B Massachusetts Avenue

905 B Mass. Ave.

Location

Kind of Pipe

Size

Size of Main

~~REPAIR~~ ~~REPAIR~~ - New Service

Location *Cam 11-16-59*

Date	Material	Amount	Total	Date	Amount
2-9-59	Labor	55 58		8-14-59	100 00
	10% O. H.	5 56	61 14	5-8-61	25 10
32'	6" Transite pipe @.70		22 40		125 10
180	Sewer Bricks @.20 /100		7 56		
2	Bags Cement @1.50		3 00		
1	20 Gesspool Cover & Frame		10 50		
1	Ton Bricksand @1.00		1 00		
4	Hrs. Pippin @4.50		18 00		
2	Hrs. Trucking @.75		1 50		
			125 10		
	<b>Labor</b>				

**TOWN OF LEXINGTON—DEPT. OF PUBLIC WORKS  
SEWER DIVISION**

DATE.....

NO. ....


The undersigned applies for the construction of a particular sewer connecting No.....  
Street and hereby agrees to comply with the Rules and Regulations governing the construction and use of Particular  
Sewers, as now or at any future time established by the Board of Selectmen.

Am't of estimate \$.....

Am't Paid \$.....

..... Owner

**Sketch of Service Here**

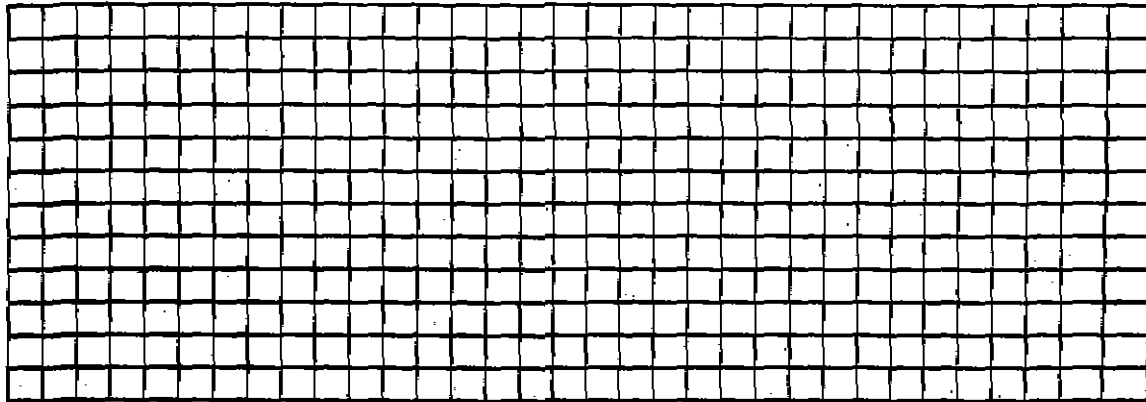

Connection made in..... Street.

Work completed.....19..

Remarks: