

Name **Richard A. Duff**

Service No. **145**

Address **905 G West. Avenue**

205C Mass. Ave.

Location

Kind of Pipe

Size

Size of Main

~~XXXXXXXXXXXX~~ New Service

Location

Coma 11-9-59

Date	Material	Amount	Total	Date	Amount
-59	LABOR	30.45		9-21-59	100.00
	10% O.H.	3.04	53.49		
41	6" Transite pipe @.70		28.70		
1	22# Transite Bend		6.21		
50	BRICK @ 4.20 per 100		2.10		
1	ton Brick Sand @1.00 per ton		1.00		
1	Gas Pipe Cover & Frame		10.50		
2	bags Cement @1.50		3.00		
3	hrs. Pippin Shovel @4.50		13.50		
2	hrs. Trucking @.75		1.50		
			<u>100.00</u>		


DATE _____

TOWN OF LEXINGTON — BOARD OF PUBLIC WORKS

SEWER DIVISION

Sketch of Service Here

905C

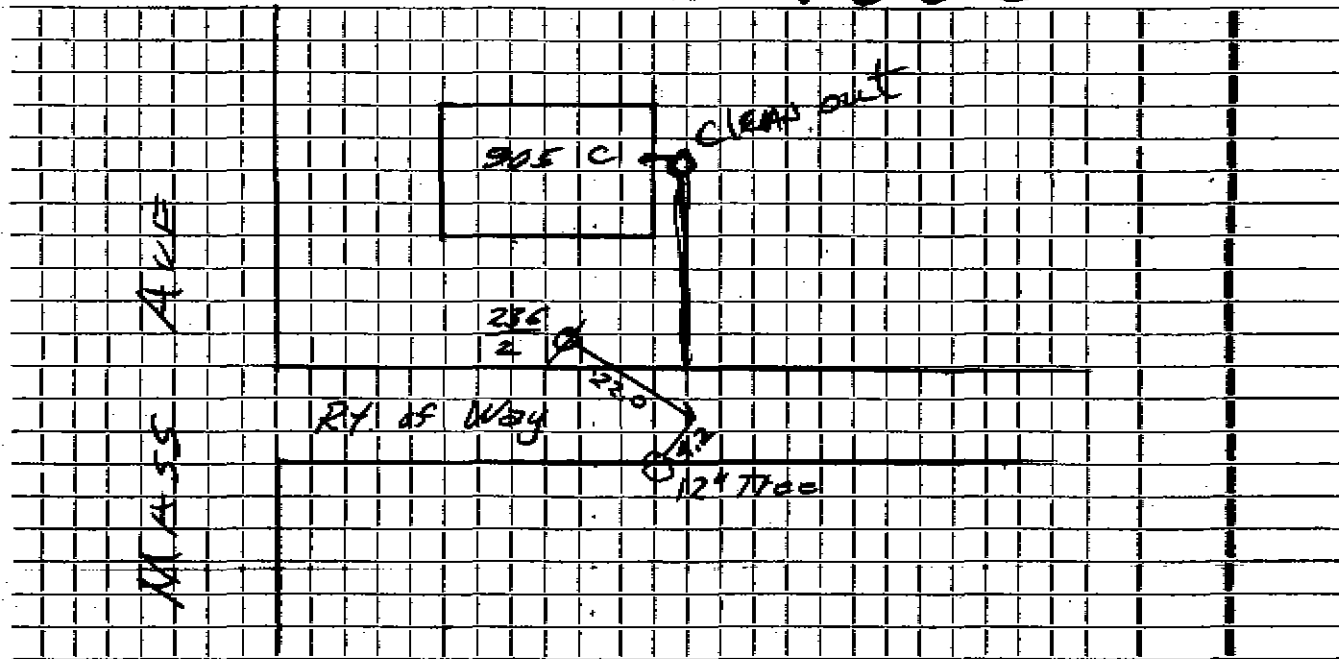

Connection made in Street. Work completed

Remarks: