


DATE _____

TOWN OF LEXINGTON — BOARD OF PUBLIC WORKS

SEWER DIVISION

Sketch of Service Here **915**

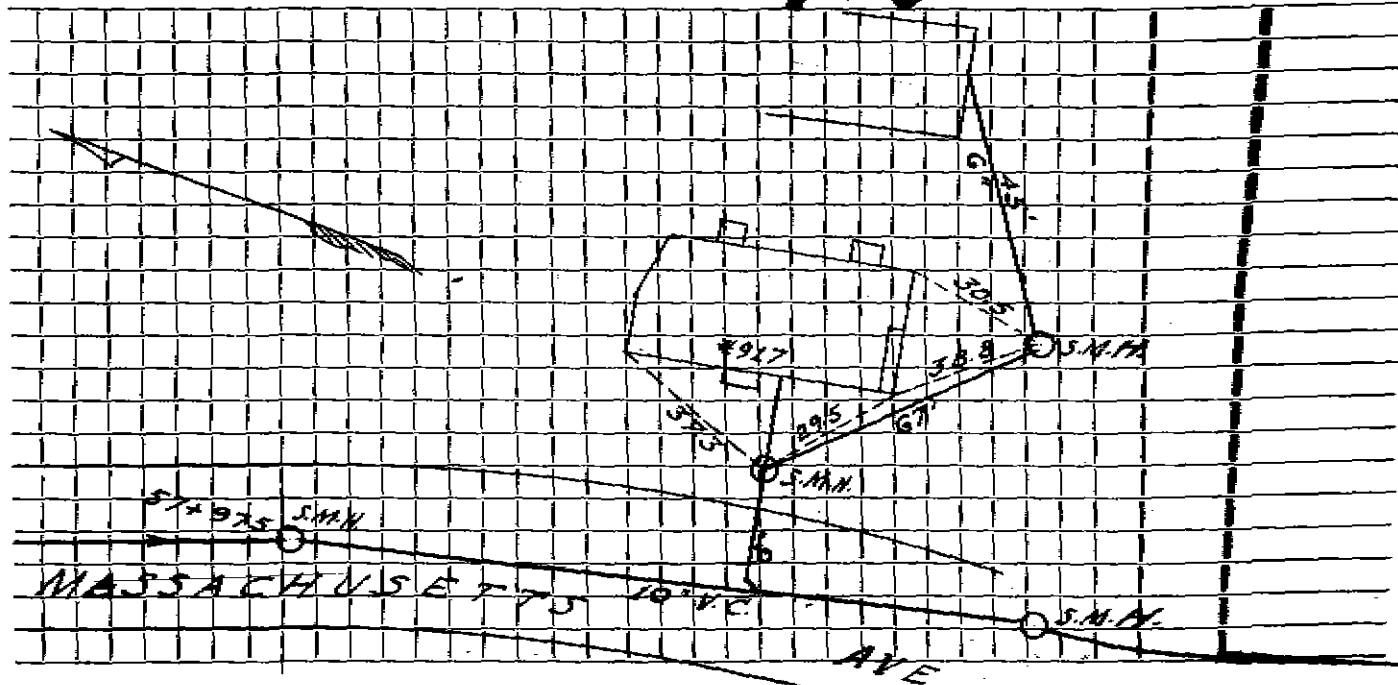

Connection made in _____ Street. Work completed _____

Remarks: *Original Service 10-4-33*