

Stephen Brughall

Service No. 91

Address 922 Mass. Avenue

Lexington

Location

Kind of Pipe

Size

Size of Main

~~REPLACEMENT~~—New Service

COM. 7-28-52

Location

Date	Material	Amount	Total	Date	Amount
6/19/52	Labor	34 80		6-13-52	Deposited 125 -
	10% overhead	3 48	38 28	7-28-52	Refunded (2 69)
	48' - 6" sewer pipe @ .342		16 41		122 31
	1 - 6" 1/8 bend		1 24		
	joint compound		2 88		
	6 hrs. Littlefield shovel		42 00		
	2 hrs. trucking		1 50		
	patching 20 x 3		20 00		
			<u>122 31</u>		
	Labor				

TOWN OF LEXINGTON—DEPT. OF PUBLIC WORKS
SEWER DIVISION

DATE.....

NO.


The undersigned applies for the construction of a particular sewer connecting No.....
Street and hereby agrees to comply with the Rules and Regulations governing the construction and use of Particular
Sewers, as now or at any future time established by the Board of Selectmen.

Am't of estimate \$.....

Am't Paid \$.....

..... Owner

Sketch of Service Here

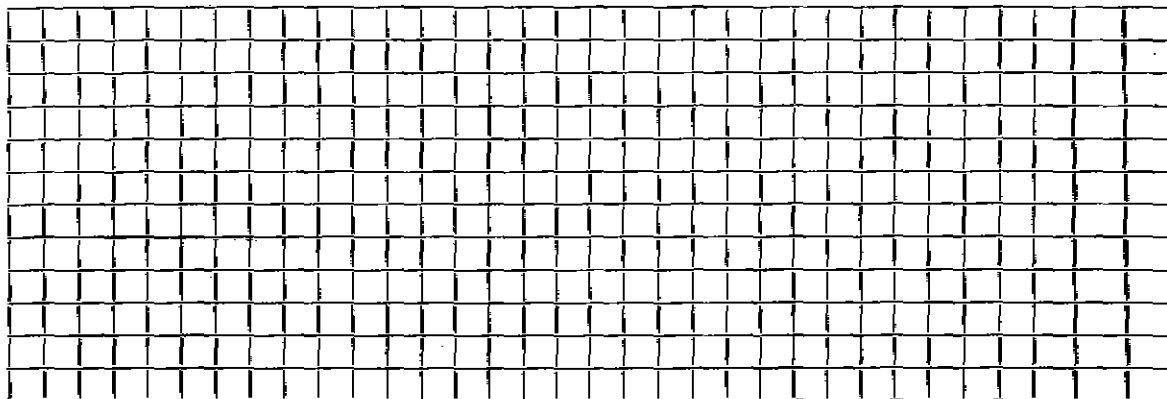

Connection made in..... Street.

Work completed..... 19..

Remarks: