

Name **Mrs. Mabel Ianman**
 Address **924 Massachusetts Avenue**
Lexington

Service No. **61-B**

Location **924 Mass. Avenue**

Kind of Pipe **New Service** Size **Com. 11-6-50** Size of Main **Location**

Date	Material	Amount	Total	Date	Amount
. 14 '50	Labor	30 91		Aug 15 '50 Deposited	100 00
15 '50	"	10 04		11-30-54 Paid	(10 91)
	10% Overhead	4 10	45 05		110 91
	70' - 6" Sewer Pipe		19 60		
	1 - 6" Elbow		1 56		
	Joint Compound		4 20	Bills sent 11-15-50	
	4 hrs. Littlefield Shovel		28 00	" " 3-7-52	
	2 hrs. Trucking		1 50		
	Patching 11 x 3		11 00		
			110 91		
	Labor				

TOWN OF LEXINGTON—DEPT. OF PUBLIC WORKS

SEWER DIVISION

DATE

NO.


The undersigned applies for the construction of a particular sewer connecting No.
Street and hereby agrees to comply with the Rules and Regulations governing the construction **and use of Particular**
Sewers, as now or at any future time established by the Board of Selectmen.

Am't of estimate \$.....

Am't Paid \$.....

..... Owner

Sketch of Service Here

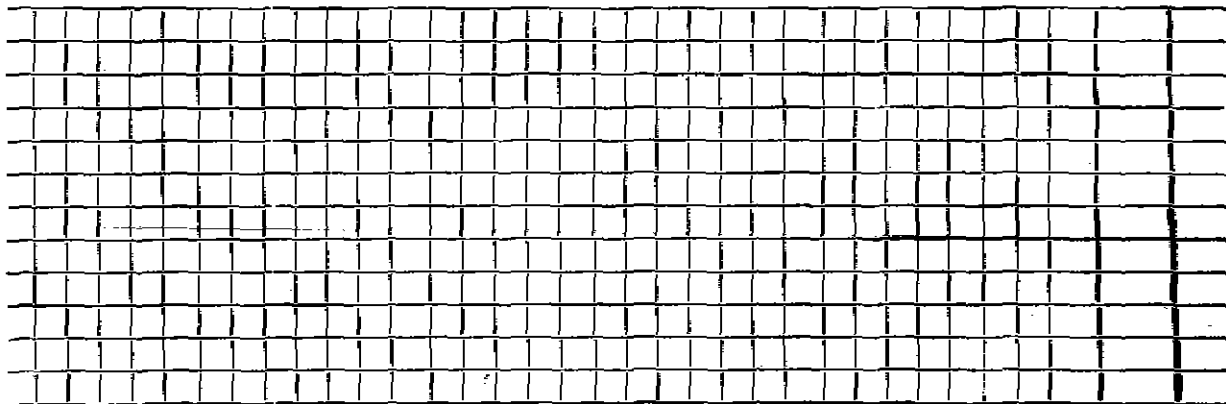

Connection made in Street.

Work completed 19..

Remarks: