

Name **George Mahoney**

Service No. 134 (1956)

Address **927 Mass. Avenue**

Location

Comm. 2/25/57

Kind of Pipe

Size

Size of Main

~~Repair Record~~ **New Service**

Location

Date	Material	Amount	Total	Date	Amount
10/19/56	Labor	92 39		9-17-56	<i>Deposit</i> \$ 225 00
	10% overhead	9 24	101 63	4-12-57	<i>Paid</i> 17 43
	72' - 6" Sewer Pipe @ .435		31 32		242 43
	Joint compound		4 32	3-26-02	<i>Respond and</i>
	4 hrs. Compressor @ 2.75		11 00		<i>MEASURE</i>
	2 hrs. Trucking @ .75		1 50		
	8 2/3 hrs. Littlefield Shovel @ .50	8.50	75 66		
	19x3 Patch		19 00		
			242 43		
	Labor				
					<i>Bill sent 2/27/57</i>

TOWN OF LEXINGTON—DEPT. OF PUBLIC WORKS
SEWER DIVISION

DATE


NO.

The undersigned applies for the construction of a particular sewer connecting No.
Street and hereby agrees to comply with the Rules and Regulations governing the construction and use of Particular
Sewers, as now or at any future time established by the Board of Selectmen.

Am't of estimate \$.....

Am't Paid \$.....

..... Owner

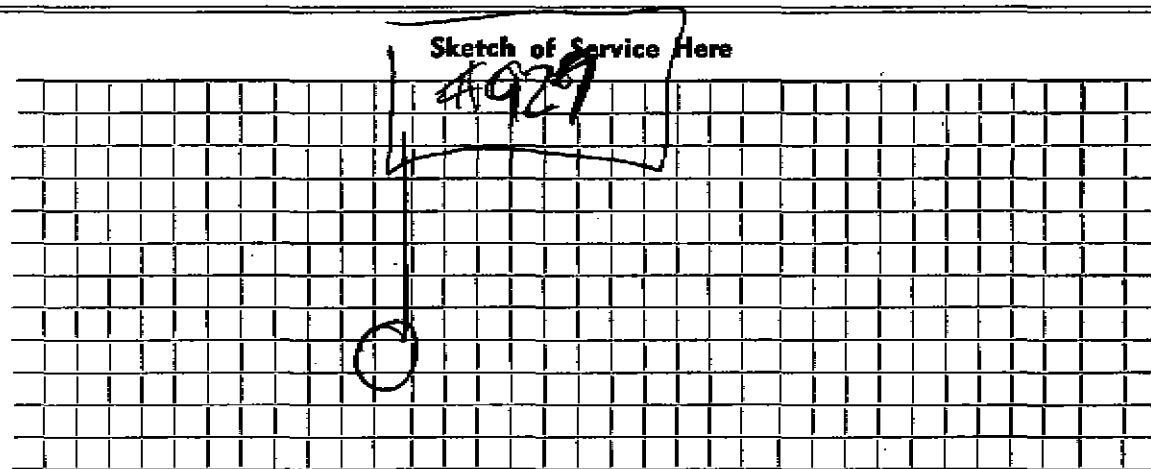

Connection made in Street. Work completed 19..

Remarks: *Can be flushed from street*