

Address 1000 MASSACHUSETTS AVENUE,

935 MASS. AVE

Location 935 Massachusetts Ave.

Kind of Pipe

Size

Size of Main

Repair—Renewal—New Service

Location

Date 1943	Material	Amount	Total	Date	Amount
May 11	3 hrs. @ 60¢	1 80		Apr 26 1943 Deposited	200 00
7/26/43	128 " @ 65¢	83 20		Aug 7 1943 Paid	45 37
	64 " @ 70¢	44 80		and bill 7/26/43	445 37
	40 1/2 " @ 80¢	32 40	162 20 ✓		
	10% Overhead		16 22 ✓		
	58' 6" Sewer Pipe @ 16¢		9 28 ✓		
	1 6" Elbow		70 ✓		
	Joint compound		3 49 ✓		
	Compressor, 3 hrs. @ 2.25		6 75		
	Trucking, 3 hrs. @ 75¢		2 25 ✓		
	Trench repairs		24 48 ✓		
			225 37		
	Labor				

Reading Pipe, Inc., Lexington

*Bill for 45.37 cent 7/27/43*

TOWN OF LEXINGTON—BOARD OF PUBLIC WORKS  
SEWER DIVISION

DATE April 26, 1943

NO. \_\_\_\_\_


The undersigned applies for the construction of a particular sewer connecting No. 935 Mass Ave Street and hereby agrees to comply with the Rules and Regulations governing the construction and use of Particular Sewers, as now or at any future time established by the Board of Selectmen.

Am't. of Estimate \$ 200.00

Am't. Paid \$ \_\_\_\_\_

James Holt Owner

Sketch of Service Here **935**

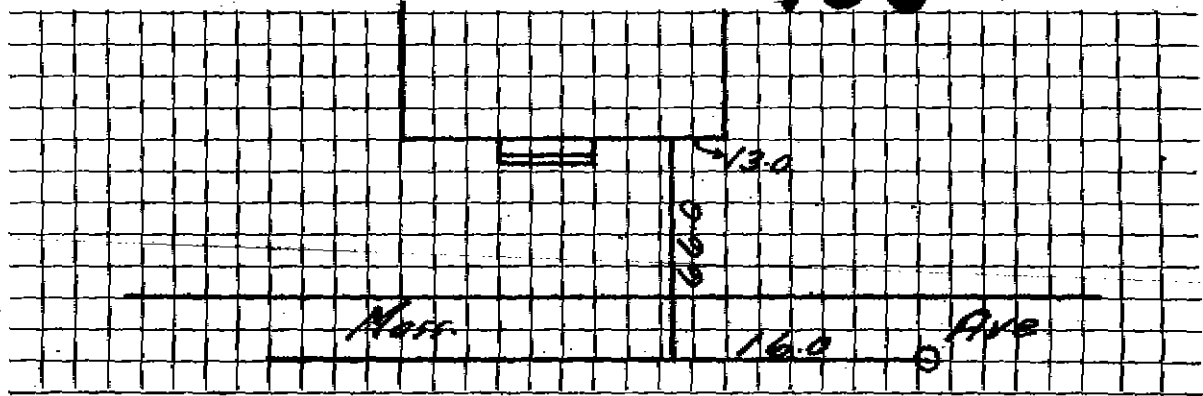

Connection made in \_\_\_\_\_ Street. Work completed \_\_\_\_\_ 19

Remarks: