


SEWER DIVISION

Sketch of Service Here

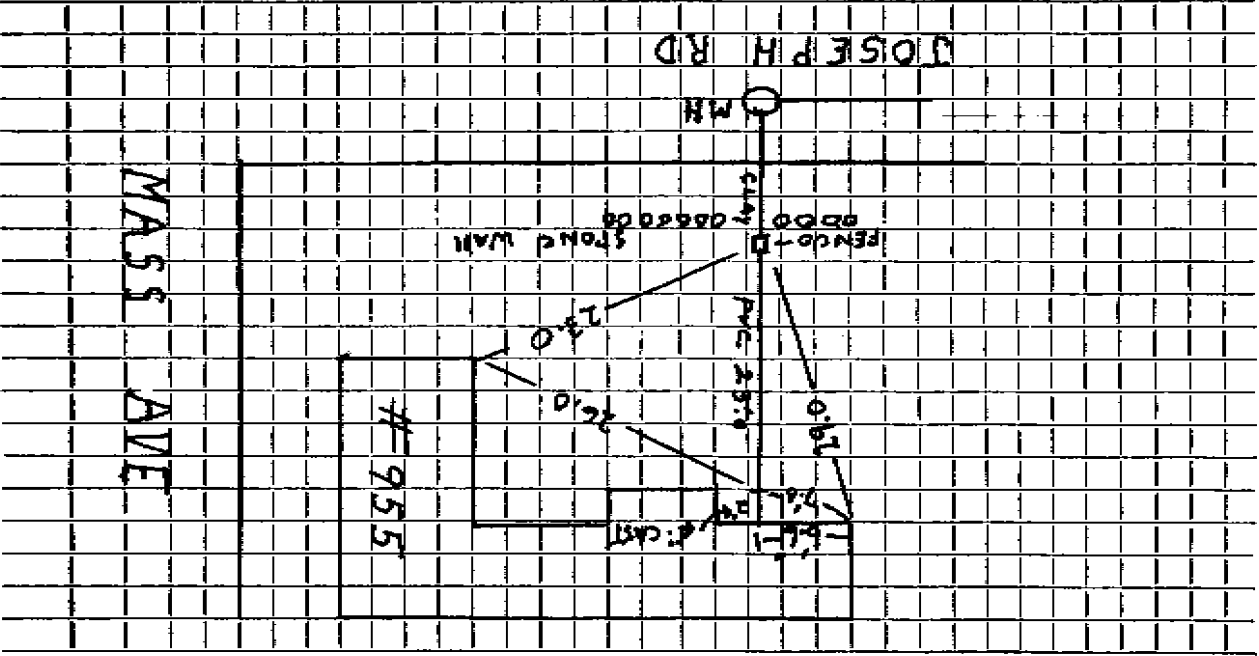

Connection made in _____ Street.

Work completed: 3/31/03

Remarks: Clay Pipe Clear to M.H.