

Georgia Sewerland

Service No. 57 619

Address

956 + 958 Mass. Ave.

956 + 958 Mass. Ave.

956 + 958 Mass. Ave. 216 County St. Burlington

Kind of Pipe

Size

Size of Main

Repaired/Replaced - New Service

Location

Date	Material	Amount	Total	Date	Amount
12-22-21 for 91.00	59' 6" Sewer Pipe @ .25	14 75			
	Sulphur & Jnts	2 36		Shot 31 1931 - Cash	90 -
	Trucking	3 00	20 11		
12/21/31	84 Hrs. Labor @ .55	46 20			
4 "	" @ .60	2 40	48 60		
	15% Overhead		7 29		
	Breaking Rd., Compressor				
	3 hrs. @ 3.00		9 00		
			85 00		
			15 - -		
			90 - -		

Jan 12 1932 - Cash

Labor

TOWN OF LEXINGTON—BOARD OF PUBLIC WORKS

SEWER DIVISION

DATE Oct. 26, 1931.

The undersigned applies for the construction of a particular sewer connecting No. 958 <sup>NO.</sup> Mass Ave Street and hereby agrees to comply with the Rules and Regulations governing the construction and use of Particular Sewers, as now or at any future time established by the Board of Selectmen.


Am't. of Estimate \$ 133.00 (*133.00*)

Am't. Paid \$

Geo Sweetland Owner

*11 1/2' x 12' trench to dig and backfill  
reach to street line.*

Sketch of Service Here

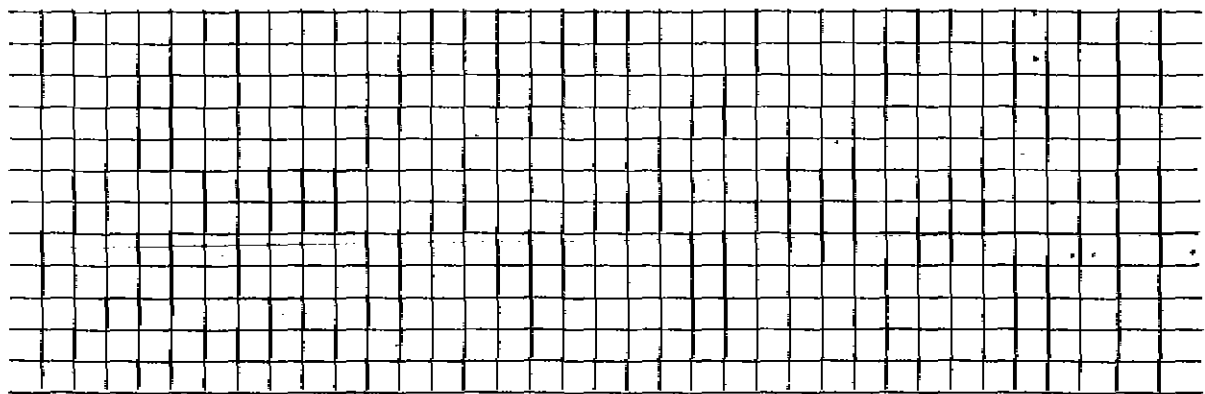

*37  
27  
10*

*90  
22  
11/2*

Connection made in \_\_\_\_\_ Street. Work completed \_\_\_\_\_ 19

Remarks: