

Name Fred L. Yeomans Service No. 6

Address 960 Mass. Avenue

Lexington

Location

Kind of Pipe

Size

Size of Main

~~EXCAVATION~~ New Service

COM. 6-16-52

Location

Date	Material	Amount	Total	Date		Amount
29/52	Labor	66 33		3-7-52	Deposited	250 00
30/52	"	27 97		6-16-52	Refunded	(129 24)
	10% overhead	9 43	103 73			210 76
	66' - 6" sewer pipe @ .342		22 57			
	Joint compound		3 96			
	7 hrs. Littlefield shovel @ 7.00	49 00				
	2 hrs. Hough loader @ 3.00		6 00			
	2 hrs. trucking		1 50			
	patching 24 x 3		24 00			
			210 76			

**Labor**

TOWN OF LEXINGTON—DEPT. OF PUBLIC WORKS  
SEWER DIVISION

DATE .....

NO. .....


The undersigned applies for the construction of a particular sewer connecting No. .....  
Street and hereby agrees to comply with the Rules and Regulations governing the construction **and use of Particular**  
Sewers, as now or at any future time established by the Board of Selectmen.

Am't of estimate \$250.....

Am't Paid \$250.....

..... Owner

Sketch of Service Here

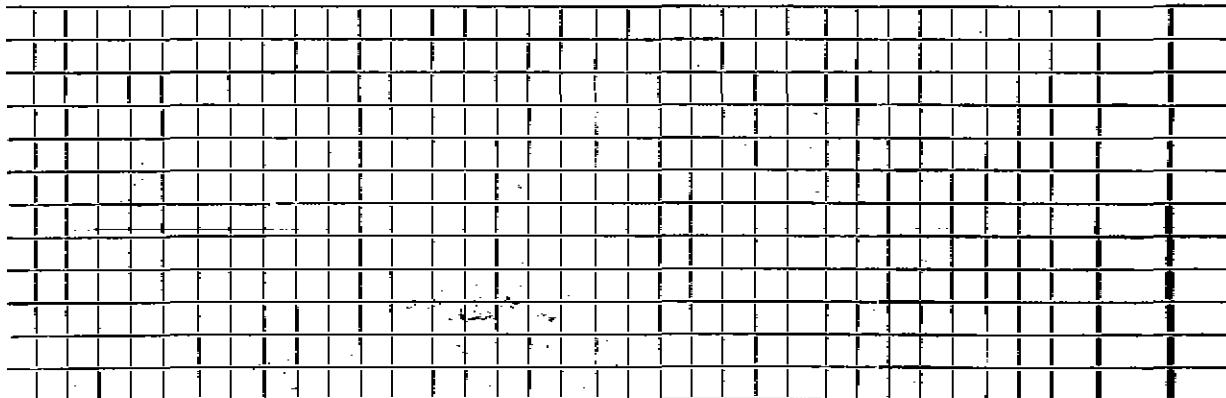

Connection made in ..... Street.

Work completed ..... 19..

Remarks: