

Name **Alan Asetta**  
 Address **964 Mass. Avenue**

Service No. **24**

Location

Kind of Pipe

Size

Size of Main

~~Work~~ ~~Renewal~~ ~~New Sewer~~ W.O. #2063

Location **FEB 10 1975**


Date	Material	Amount	Total	Date	Amount	
4-74	Labor	169.92		5-8-74	Deposit	400.00
8-74	Labor	16.77	199.39	2-10-75	Retard	73.44
	10% O.H.	19.94	\$219.33			329.59
23'	6" Transite Pipe	@1.10	25.30	7-11-52		
1	Adapter		3.29	68'	6" Sewer Pipe	
1	22 1/2" Bend- 2 Ft.		9.52	1	6" Elbow	
1	11 1/2" El		3.94			
1/2	Bag Cement		1.10			
2	Doz. Bricks	@1.07	1.68			
1 1/2	Ton Hot Top	@12.15	18.23			
	Loam, Seed, Lime & Fertilize		8.00			
5	Hrs. Trucking	@3.00	15.00			
3	Hrs. Pick up	@1.50	4.50			
3	Hrs. Town Shovel	@6.50	19.50			
			\$329.59	2-25-74	Letter sent	
				2-21-74	Roots	
				1-29-74	Roots	
				12-29-73	Roots	

DATE \_\_\_\_\_

TOWN OF LEXINGTON — BOARD OF PUBLIC WORKS

SEWER DIVISION

Sketch of Service Here

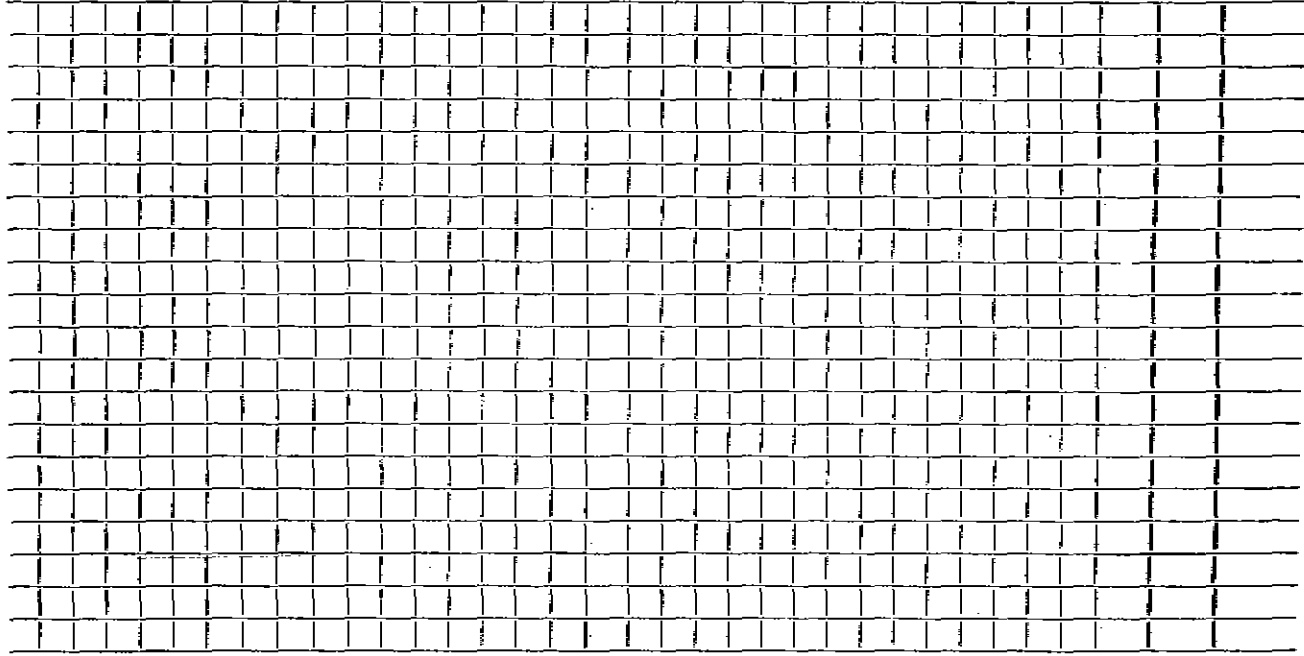

Connection made in ..... Street. Work completed .....

Remarks: .....  
.....  
.....