

Name Saverio Nardelli

Service No. 19 619

Address ~~731 Main Street, Watertown, Mass.~~

991-993 Mass Ave. Location 991-993 Mass. Ave.,

Kind of Pipe

Size

Size of Main

~~Repair-Renewal~~ - New Service

Location

Date 1942	Material	Amount	Total	Date	Amount
December	80 1/2 Hrs. @ 60¢	48 30		Dec 9, 1942 Deposited	93 00
	24 1/2 " @ 65¢	15 93		April 1943 Paid	15 00
	11 1/2 " @ 75¢	8 63	72 86		
	10% Overhead		7 29		
	46' 6" Sewer pipe @ 16¢		7 36		
	Jointing compound		2 76		
	Tractor - 1 hr.		1 25		
	Trucking - 2 hrs. @ 75¢		1 50		
	Trench repairs		15 00		
			<u>108 02</u>		
	Labor			Bill sent 1/7/43	
					<u>108 02</u>

110⁰²

TOWN OF LEXINGTON—BOARD OF PUBLIC WORKS SEWER DIVISION

DATE _____

NO. _____

The undersigned applies for the construction of a particular sewer connecting No. 991-993 Mass. Ave Street and hereby agrees to comply with the Rules and Regulations governing the construction and use of Particular Sewers, as now or at any future time established by the Board of Selectmen.


Am't. of Estimate \$ 93⁰⁰

Am't. Paid \$ _____

Saverio Hardell Owner
131 Main St Watertown Mass.

Sketch of Service Here

991 + 993

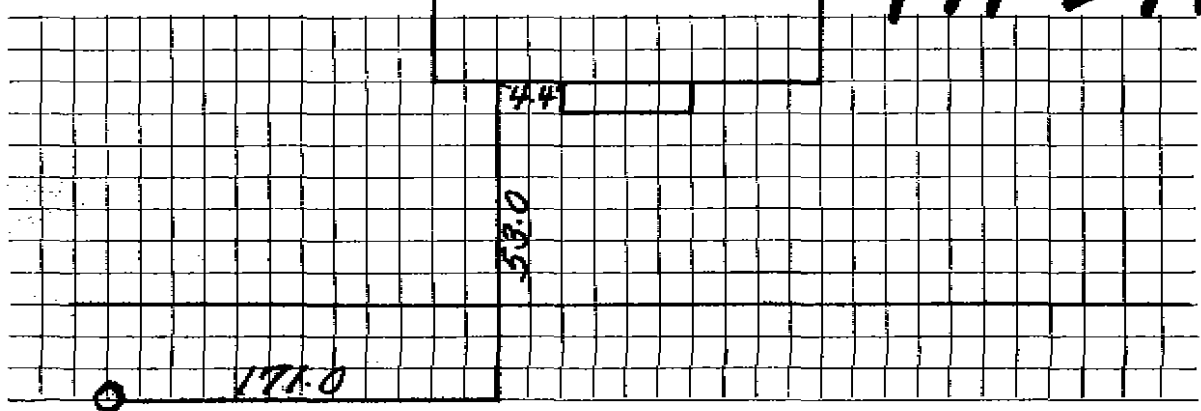

Connection made in _____ Street.

Work completed _____ 19

Remarks: