


DATE July 2017

TOWN OF LEXINGTON — BOARD OF PUBLIC WORKS
SEWER DIVISION

Sketch of Service Here

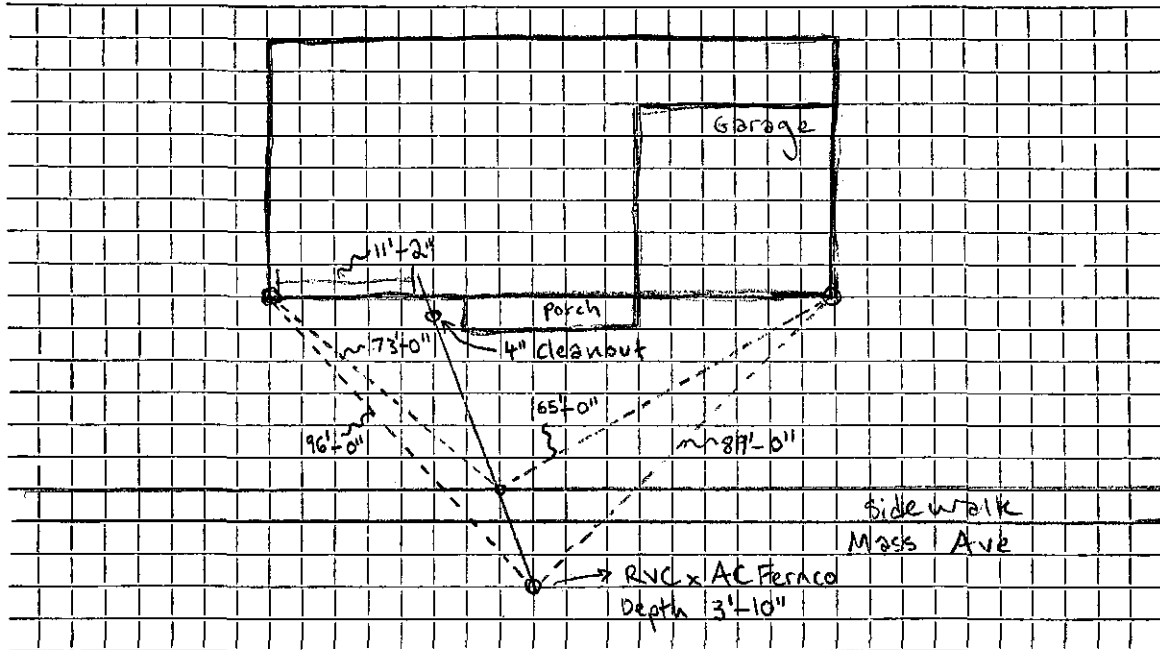

Connection made in 2520 Massachusetts Ave Street. Work completed

Remarks: 4 inch Cleanout is 2'-0" from foundation. Total sewer pipe is 94'-0".

Foundation, Bench Sidewalk are 68'-0" apart. Bench Sidewalk to tie invert, invert Street lateral 26'-0"