




DATE \_\_\_\_\_

TOWN OF LEXINGTON — BOARD OF PUBLIC WORKS  
SEWER DIVISION

Sketch of Service Here

LOT #3

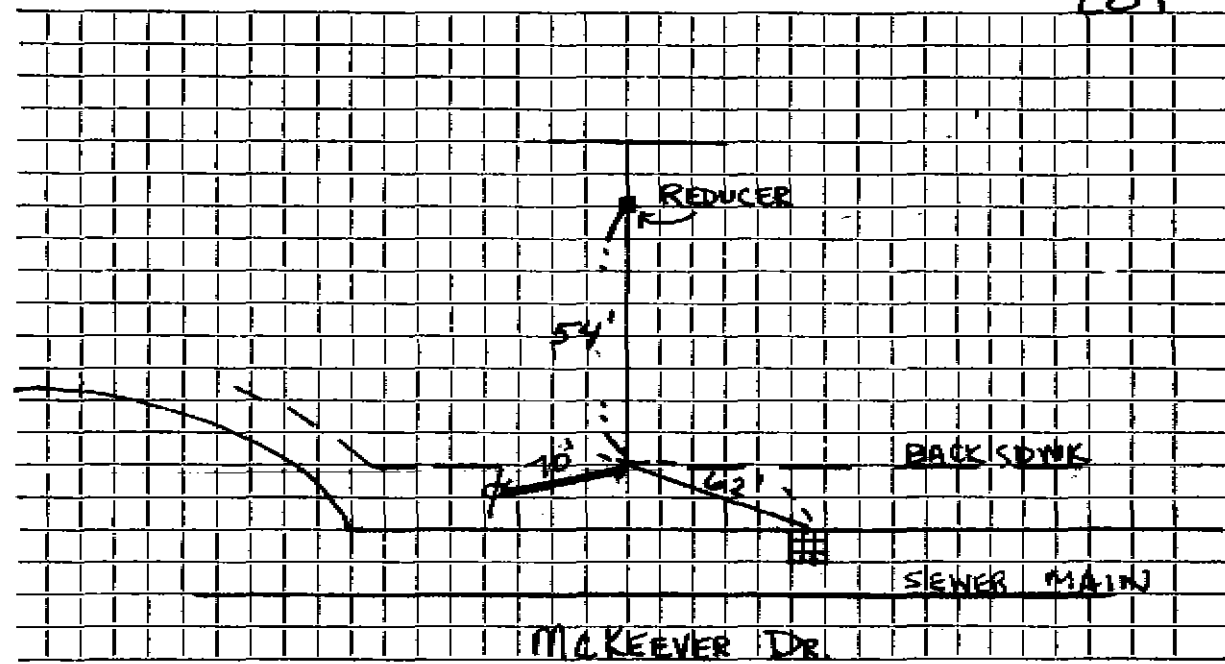

Connection made in McKEEVER DR Street. Work completed .....

Remarks: NO OUTSIDE TIES .....