




DATE 7-27-'89

TOWN OF LEXINGTON — BOARD OF PUBLIC WORKS

SEWER DIVISION

LOT # 1

Sketch of Service Here  
# 4 MCKEEVER DRIVE

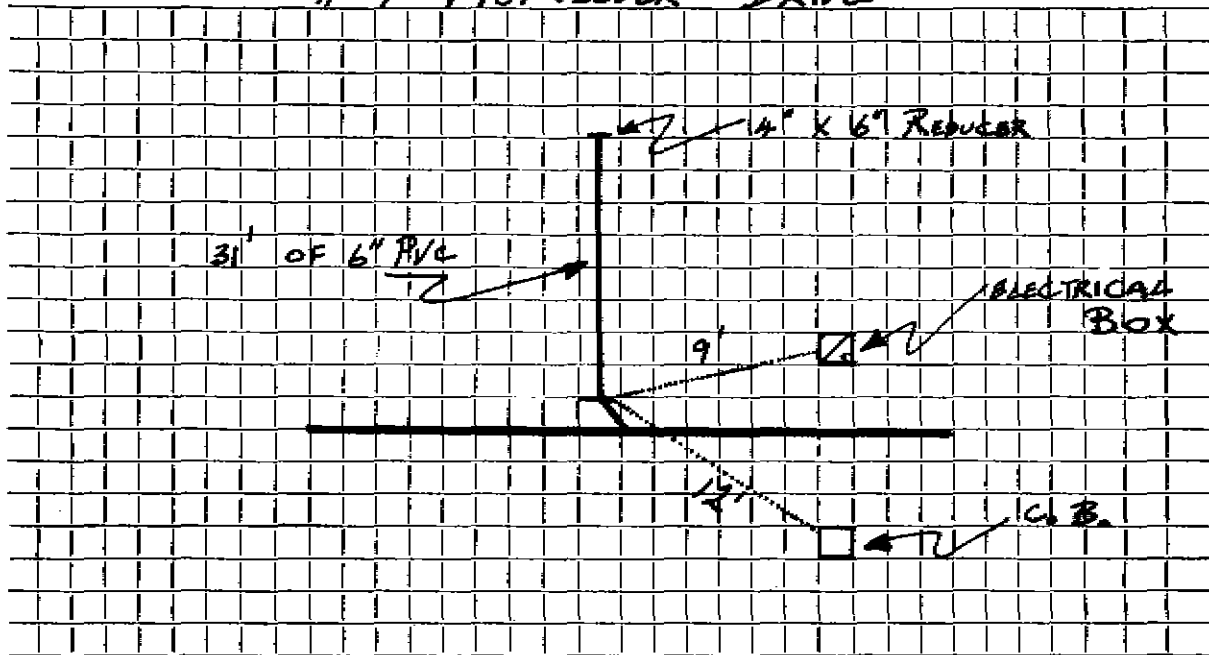

Connection made in ... MCKEEVER DRIVE Street. Work completed .....

Remarks: INSPECTED 7-27-'89 BY MB. INSTALLED BY J. REDMOND.