



DATE 8/11/92


TOWN OF LEXINGTON — BOARD OF PUBLIC WORKS

SEWER DIVISION

LOT # 2

Sketch of Service Here

5

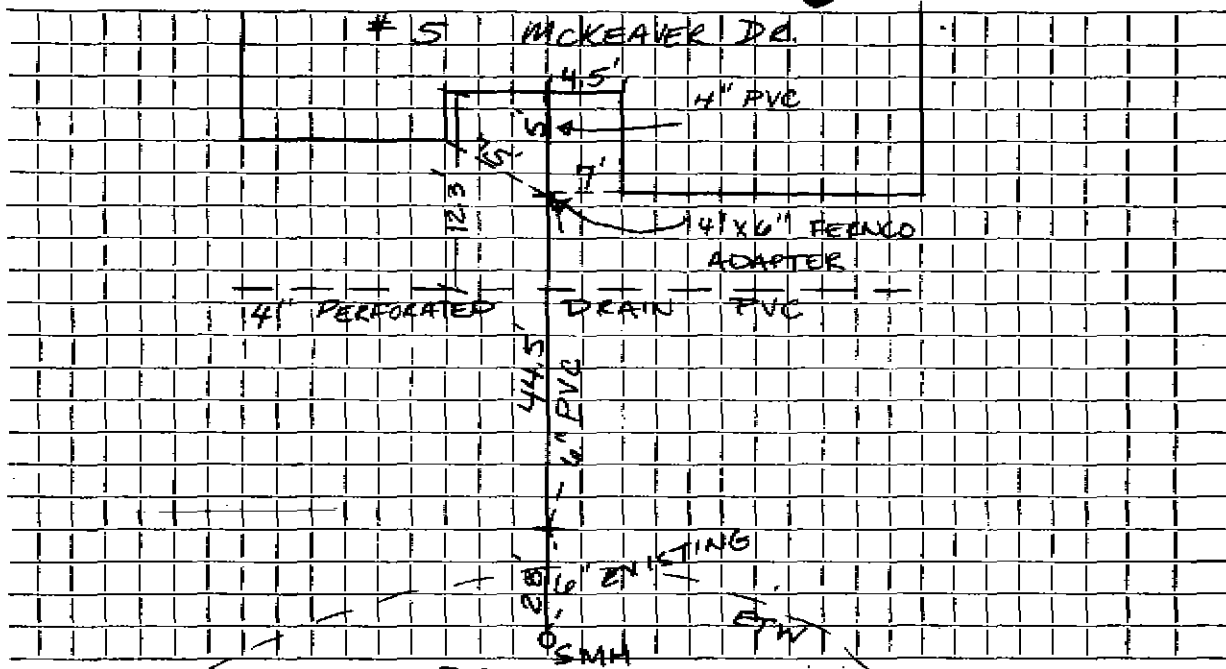

Connection made in MCKEAVER DR. Street. Work completed

Remarks: CONTR: J. McLAUGHLIN