


029

DATE _____

TOWN OF LEXINGTON — BOARD OF PUBLIC WORKS SEWER DIVISION

7 Sketch of Service Here

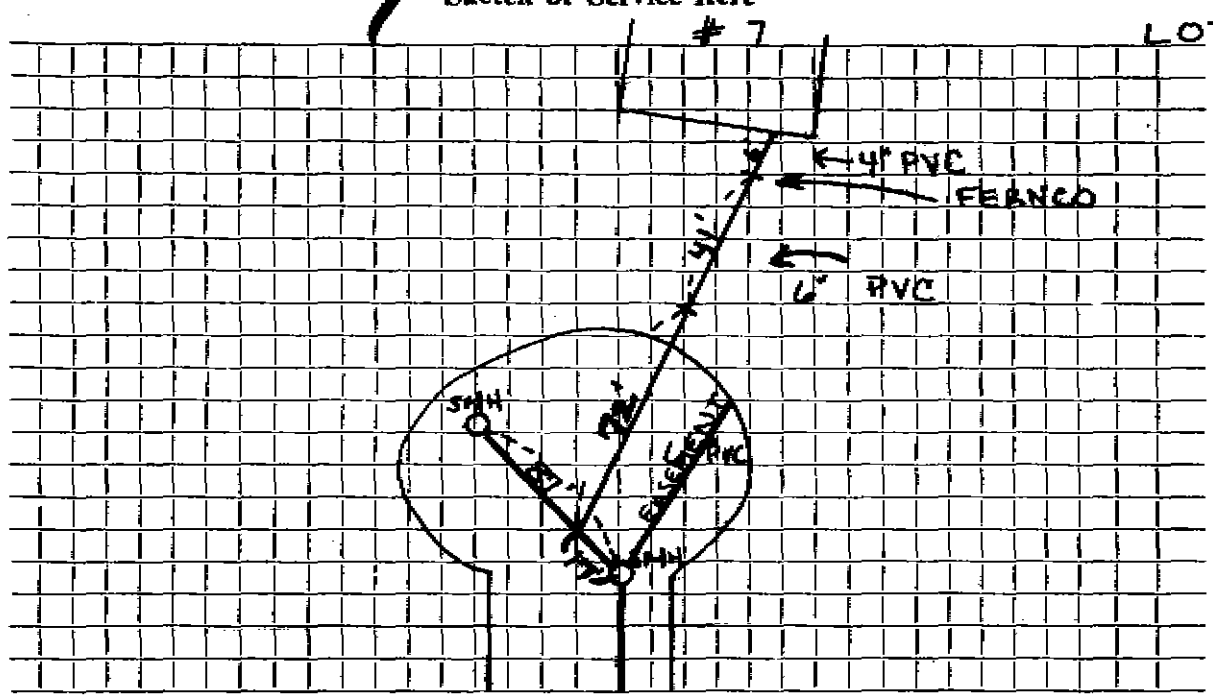

LOT #19

Connection made in .. MEAD CIRCLE Street. Work completed

Remarks:
.....
.....