


11/21/89

DATE 10-26-'90

TOWN OF LEXINGTON — BOARD OF PUBLIC WORKS
SEWER DIVISION

Sketch of Service Here **5**
#5 MEAD CIRCLE

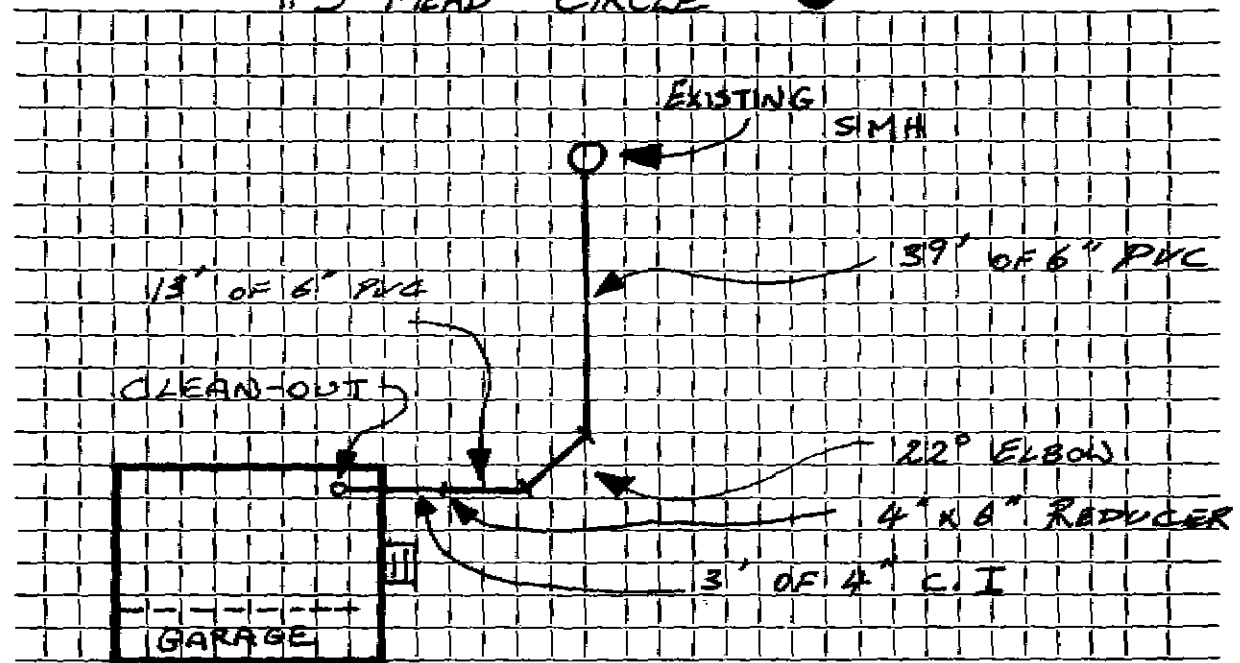

Connection made in EASEMENT ~~street~~ Work completed

Remarks: INSPECTED 11-21-'89 BY CRG. INSTALLED BY PARKNOOD