




DATE 3/31/94

TOWN OF LEXINGTON — BOARD OF PUBLIC WORKS  
SEWER DIVISION

Sketch of Service Here

2

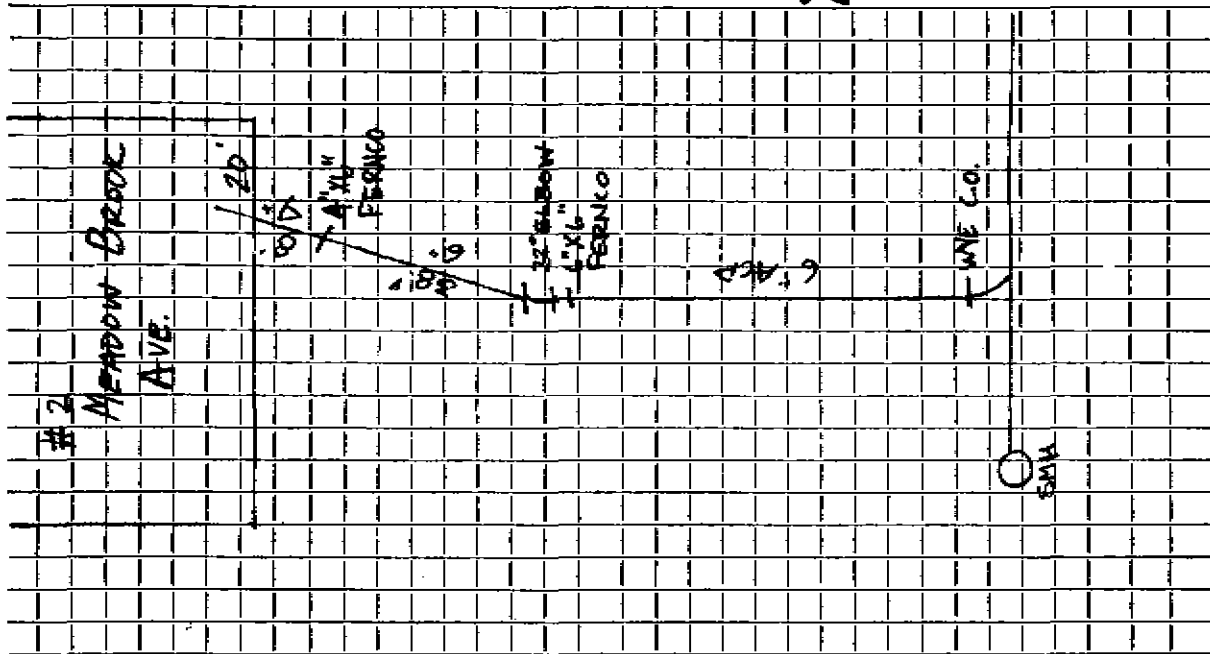

Connection made in ..... Street. Work completed .....

Remarks: Original Service 9-10-80 .....