


TOWN OF LEXINGTON — BOARD OF PUBLIC WORKS SEWER DIVISION

Sketch of Service Here

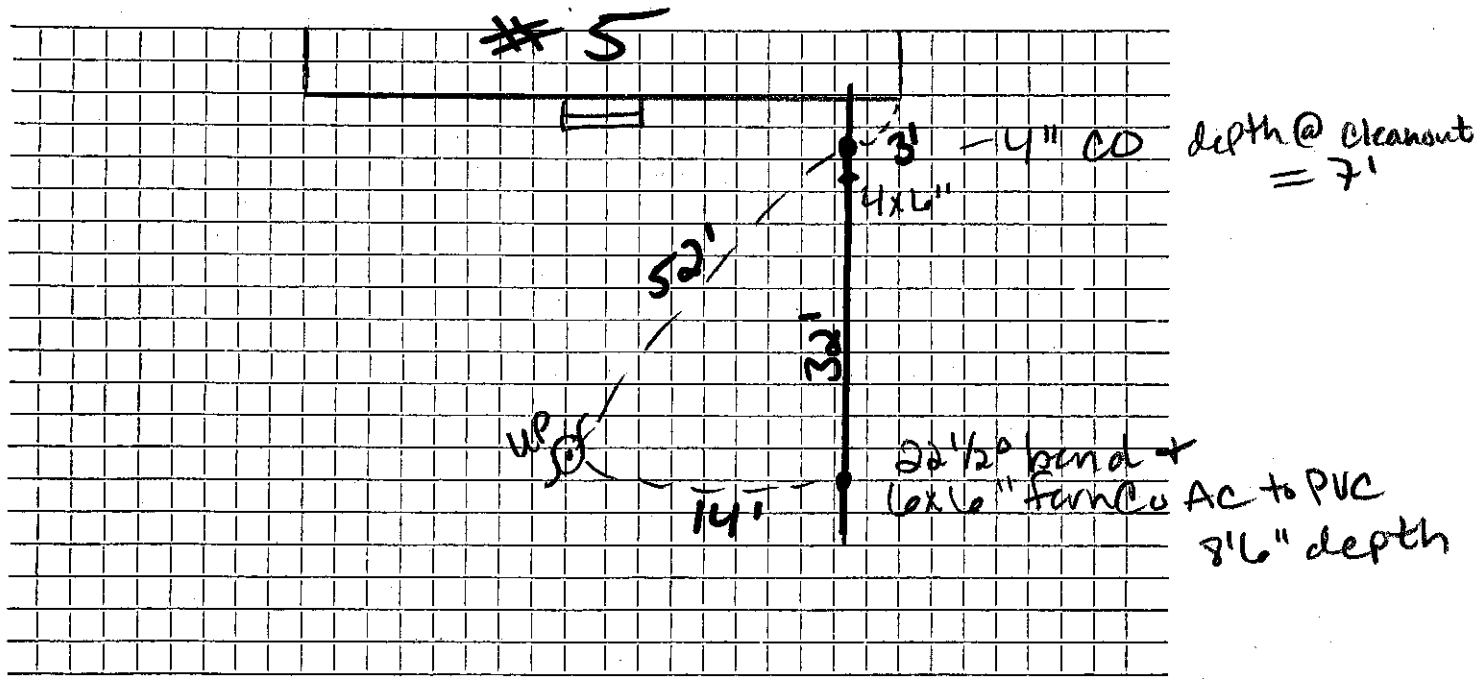

Connection made in ... Meadowbrook Ave. Street.

Work completed

Remarks: