

Name Gladys Rix

Service No. 89

Address #12 Melrose Ave.

Lot #36-37 Sta: 77 & 80 left

Location 12 Melrose Ave.

Kind of Pipe

Size 6"

Size of Main 8"

Repair—Renewal—New Service John Grant Permit #A349

Location JUL 25 1966

Date	Material	Amount	Total	Date	Amount	
9-22-64	Labor	34.74		6-29-66	Deposit	76.86
	10% O.H.	3.47	38.21			
	<del>13' 6" Transite pipe @.82</del>		16.66	9-22-64		
	<del>1 90° Transite elbow</del>		4.09	13'	6" Transite	
	<del>1 6" Adapter</del>		1.90	1	6"-90° Elbow	
	2 hrs. Town Shovel @6.50		13.00	1	6"X8" Wye	
	1 hr. Town Truck		3.00			
			76.86			
6/29/66	24' 6" Transite pipe					

DATE \_\_\_\_\_


TOWN OF LEXINGTON — BOARD OF PUBLIC WORKS

SEWER DIVISION

Sketch of Service Here **12**

Hyd. at Melrose + Albemarle  
- 100.00 -

Sill #12 - 99.28  
C.D. - 95.87  
INV. Serv. 92.85

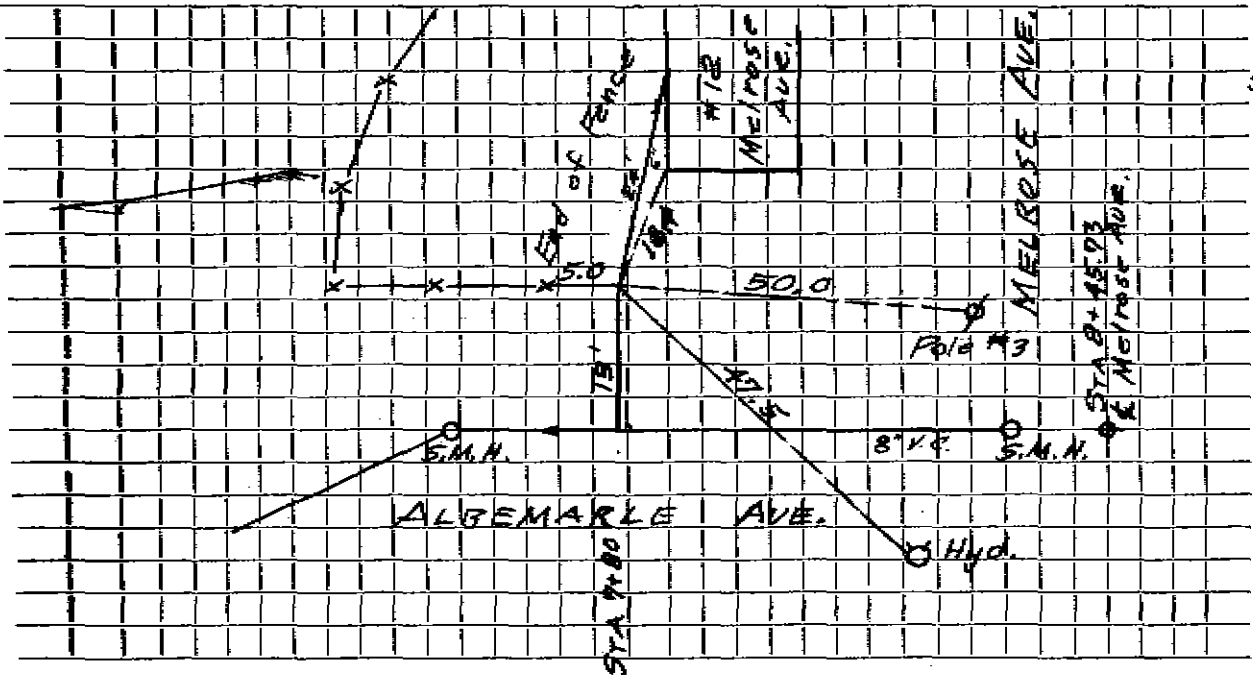

R. KAWSON AVE.

Connection made in ..... Street. Work completed .....

Remarks: .....