


DATE _____

TOWN OF LEXINGTON — BOARD OF PUBLIC WORKS

SEWER DIVISION

Sketch of Service Here

5

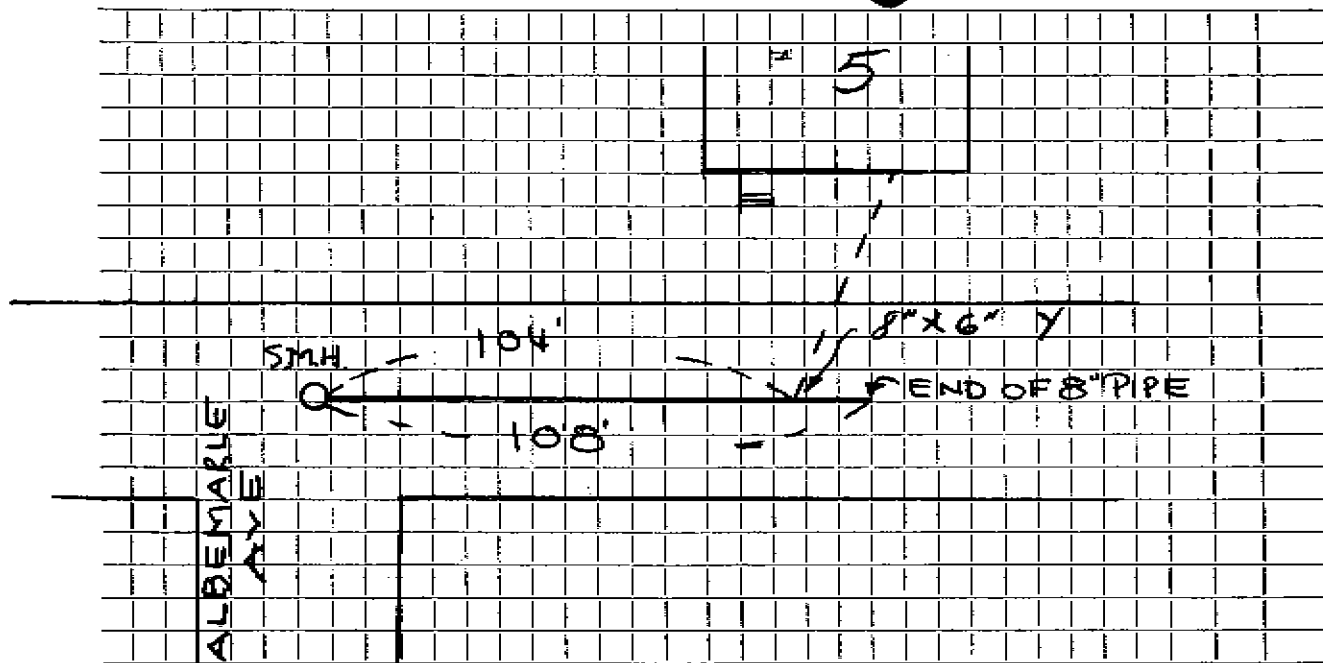

Connection made in MELROSE AVE Street. Work completed 4/20/63

Remarks: 8" A.C. SEWER MAIN INSTALLED PRIVATELY
By BUILDER, C BERNIE MALONEY