

Name Eugene Bewig

Service No. 36

Address 6 Melrose Avenue

6 Melrose Ave.

Location

Kind of Pipe

Size 6"

Size of Main 8"

~~Capital Investment~~ New Service Valued #911

Location OCT 25 1965


Date	Material	Amount	Total	Date	Amount
65	Labor	35 07		4-21-65	Deposit 100 00
	10% O.H.	3 51	38 58	10-25-65	Refund 28 48
17'	6" Transite pipe @ .82		13 94	4-26-65	71 52
2	Hrs. Town Shovel @ 6.50		13 00	17' 6" Transite	
2	Hrs. Town Truck @ 3.00		6 00	1 6" X 8" Wye	
			71 52		
167	27' 6" Transite pipe				
	10' 4" Cast Iron pipe				

DATE _____

TOWN OF LEXINGTON — BOARD OF PUBLIC WORKS

SEWER DIVISION

Sketch of Service Here **6**

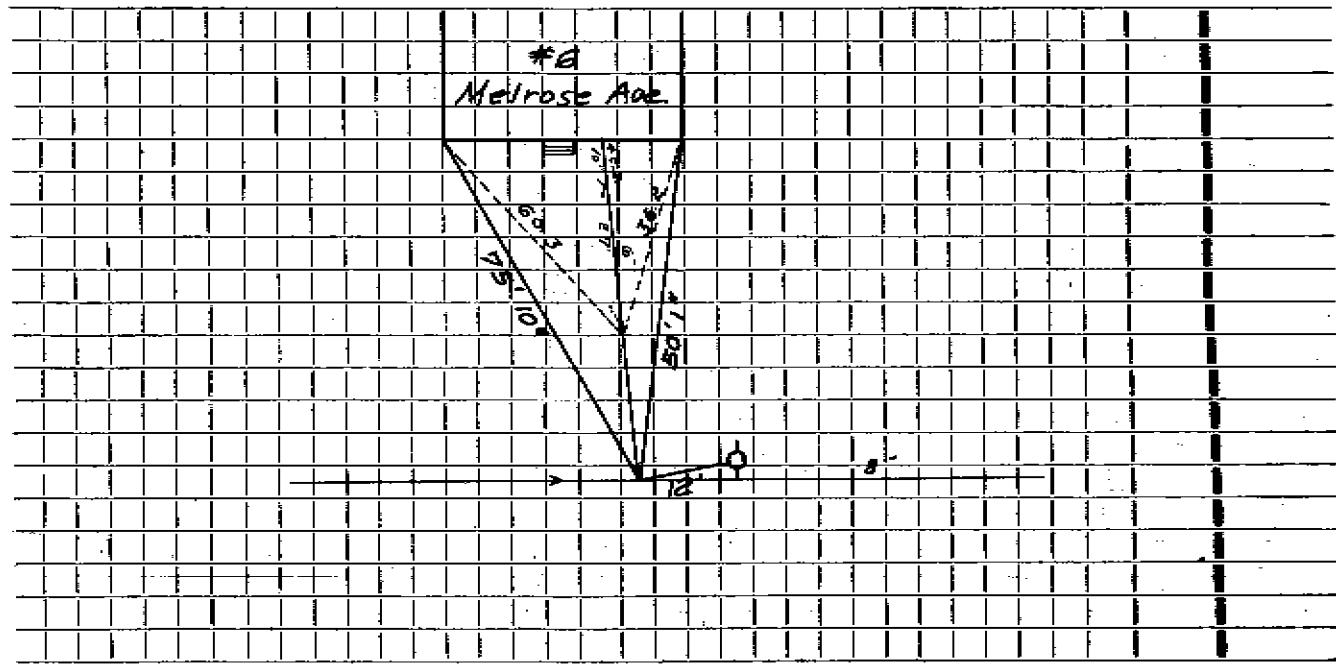

Connection made in Street. Work completed

Remarks:
.....
.....