




DATE \_\_\_\_\_

TOWN OF LEXINGTON — BOARD OF PUBLIC WORKS  
SEWER DIVISION

Sketch of Service Here

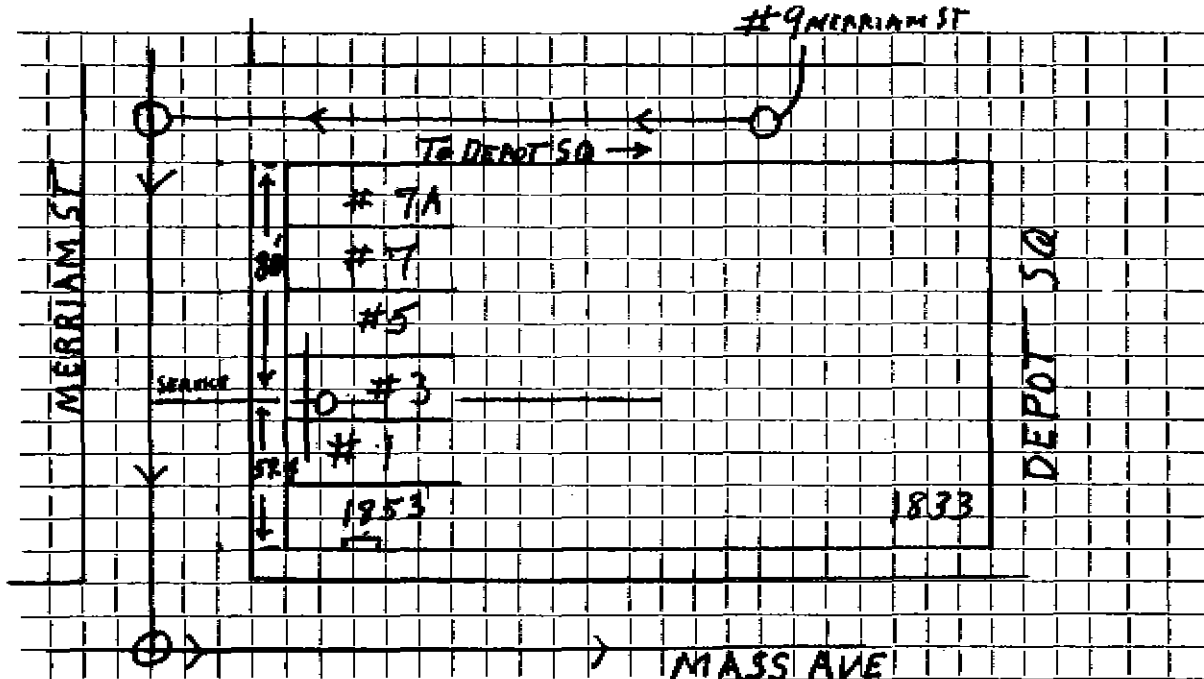

Connection made in \_\_\_\_\_ Street. Work completed \_\_\_\_\_

Remarks: CLEAN OUT IN NO. 3 MERRIAM ST. FOR ALL OF BULD. 3-4" LINES COME INT. WYE