

Name Robert Merriam

Service No. ~~28~~ 228

Address

~~10 Merriam St.~~  
~~Colman Circle~~

10 Merriam St.

Location 10 Merriam Street

Kind of Pipe

Size

Size of Main

~~Repair-Renewal~~ - New Service

Location

Date  
1936

Material

Amount

Total

Date

Amount

Dec. 9

34 hrs. @ 60¢

20 40

Feb. 5 1937 Paid

~~20 43~~

~~Com 12-24-36~~

59 " 55

32 45

52 85

10% Overhead

5 28

\$ 58 13

26' 6" Sewer Pipe @ 20¢

5 20

1 6 x 4 Reducer

60

Jointing Compound

1 50

Trucking

2 00

*Bill sent 12-24-36*

Compressor-2 hrs @ 3.50

7 00

74 43

10-21-64

SET TAPS PLUGGED

Labor

Hadley Pipe, Inc., Lexington

TOWN OF LEXINGTON—BOARD OF PUBLIC WORKS

SEWER DIVISION

DATE Dec 3 1936

NO. \_\_\_\_\_


The undersigned applies for the construction of a particular sewer connecting No. 10 Merriam St Street and hereby agrees to comply with the Rules and Regulations governing the construction and use of Particular Sewers, as now or at any future time established by the Board of Selectmen.

Am't. of Estimate \$ \_\_\_\_\_

Am't. Paid \$ \_\_\_\_\_

Robert C. Merriam Owner  
10 5 13

Sketch of Service Here **10**

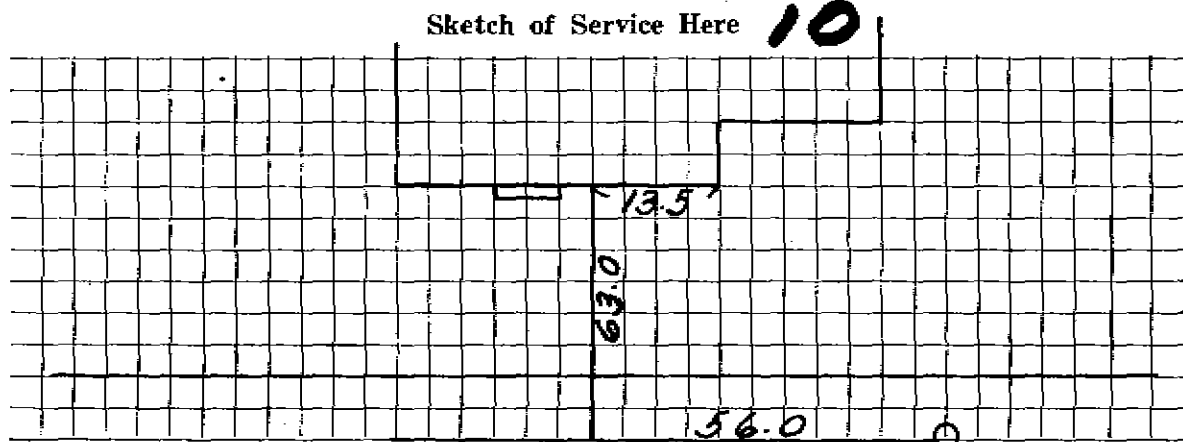

Connection made in \_\_\_\_\_ Street.

Work completed \_\_\_\_\_ 19

Remarks: