

Name Ralph H. Tucker

Service No. 50

Address 100 Meriam Street

Lexington, Mass.

Location 100 Meriam Street

Kind of Pipe

Size 6"

Size of Main 8"

~~Repair~~ ~~Renewal~~ New Service Com. 8-16-48

Location

Date	Material	Amount	Total	Date	Amount
June 8, '48	Labor	47 07	47 07	June 1, 48	Repeated 225 00
	10% Overhead		4 71	Aug 13, 48	Refunded 114 80
	82' - 6" Sewer Pipe @.26		21 32		110 20
	1 - 6" 1/8 "end		1 50		
	1 - 6" x 6" Y		1 18		
	Joint Compound		4 92		
	Littlefield Shovel 4 hrs. @ 7.00	28 00			
	Trucking 2 hrs. @.75		1 50		
			110 20		
	Labor				

TOWN OF LEXINGTON—DEPT. OF PUBLIC WORKS
SEWER DIVISION

DATE

NO.


The undersigned applies for the construction of a particular sewer connecting No.
Street and hereby agrees to comply with the Rules and Regulations governing the construction **and use of Particular**
Sewers, as now or at any future time established by the Board of Selectmen.

Am't of estimate \$.....

Am't Paid \$.....

..... Owner

Sketch of Service Here

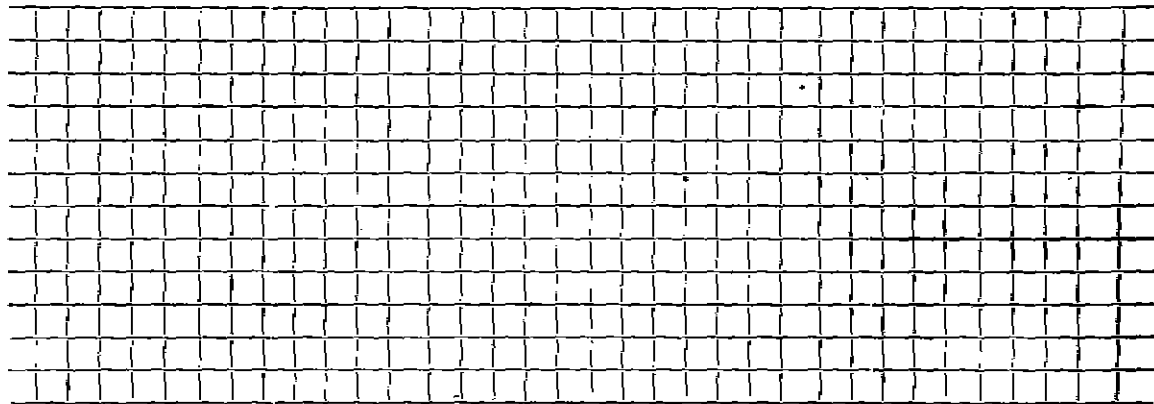

Connection made in Street.

Work completed 19..

Remarks: