

Name Annie Crooks

Service No. 15

Address 101 Meriam Street

101 Meriam ST.

Location

Kind of Pipe

Size 6"

Size of Main 8"

~~Repair~~ - Renewal - ~~Work~~ ~~Service~~

W.O.# 8577

Location

JUN 29 1964

Date	Material	Amount	Total	Date	Amount
-64	Labor	81.04		3-5-64	150.00
2-64	"	34.29	115.33	6-29-64	11.68
	10% O.H.	11.53	126.86		161.68
	55' 6" Transite pipe @.82		45.10		
	1 bag Cement		1.50		
	18 x 3 Patch		18.00		
	7 yds. Loam @3.00		21.00		
	5 hrs. Town Shovel @6.50		32.50		
	3 hrs. Trucking @3.00		9.00		
			253.96		
	$253.96 \div 25 = 21.16 \times 15 \text{ years } 11 \text{ months } = 161.68$				

The layout and location of this sewer service connection is in accordance with my request and instructions to the Department of Public Works for the Town of Lexington.

I appreciate that there are changes in alignment of pipe underground without accessible cleanouts, and I further assume all responsibility and any costs that may be involved due to stoppages.

Ruth A. Tucker  
Name


100 Meriam St., Lexington, Mass.  
Address

DATE \_\_\_\_\_

TOWN OF LEXINGTON — BOARD OF PUBLIC WORKS

SEWER DIVISION

Sketch of Service Here **101**

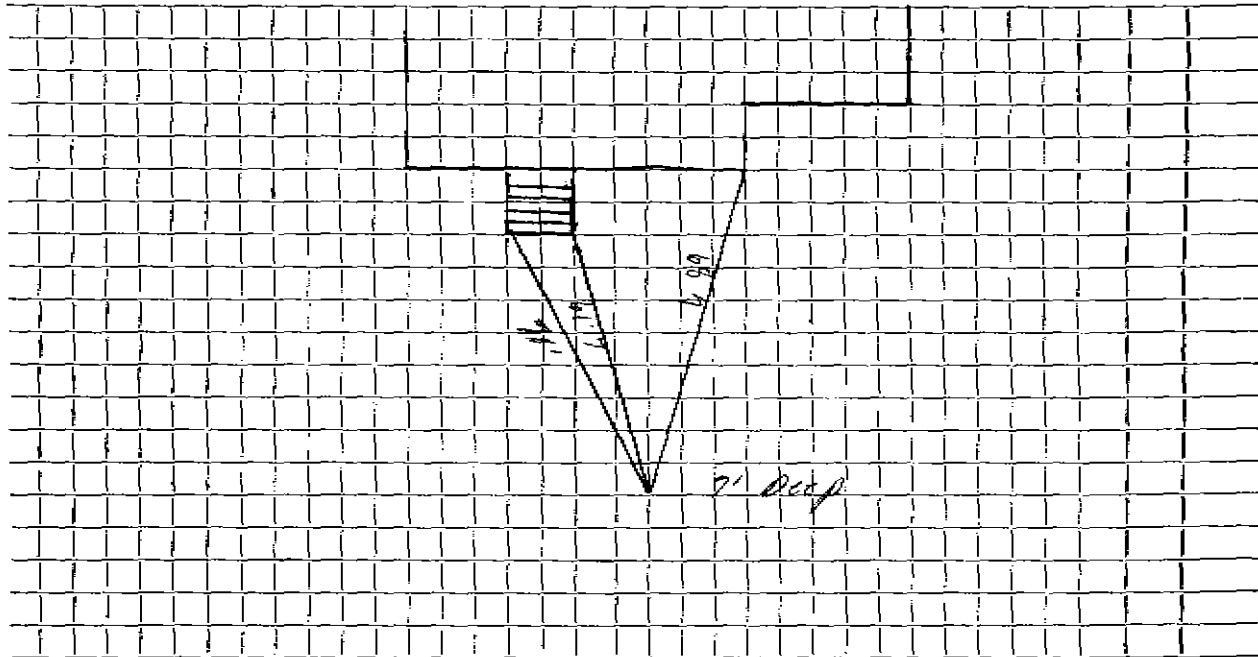

Connection made in ..... Street. Work completed .....

Remarks: *Original Service 6-7-98 (64'-6" Sewer Pipe, 1-6" 1/8 Bend*