

Name William B. Porter

Service No. 119

Address 102 Meriam Street

Lexington, Mass.

Location 102 Meriam Street

Kind of Pipe

Size 6"

Size of Main 8"

Repair—Renewal—New Service Com. 8-15-48

Location

Date	Material	Amount	Total	Date	Amount
June 9, 48	Labor	22 28	22 28	June 1, 48	100 00
	10% Overhead		2 23	Aug 20 48	38 93
	58' - 6" Sewer Pipe @ .26		15 08		67 07
	1 - 6" 1/8 Bend		1 50		
	Joint Compound		3 48		
	Littlefield Shovel 3 hrs. @ 7.00		21 00		
	Trucking 2 hrs. @ .75		1.50		
			67 07		
	<b>Labor</b>				

TOWN OF LEXINGTON—DEPT. OF PUBLIC WORKS  
**SEWER DIVISION**

DATE .....

NO. ....


The undersigned applies for the construction of a particular sewer connecting No. ....  
Street and hereby agrees to comply with the Rules and Regulations governing the construction **and use of Particular Sewers**, as now or at any future time established by the Board of Selectmen.

Am't of estimate \$.....

Am't Paid \$.....

..... Owner

**Sketch of Service Here**

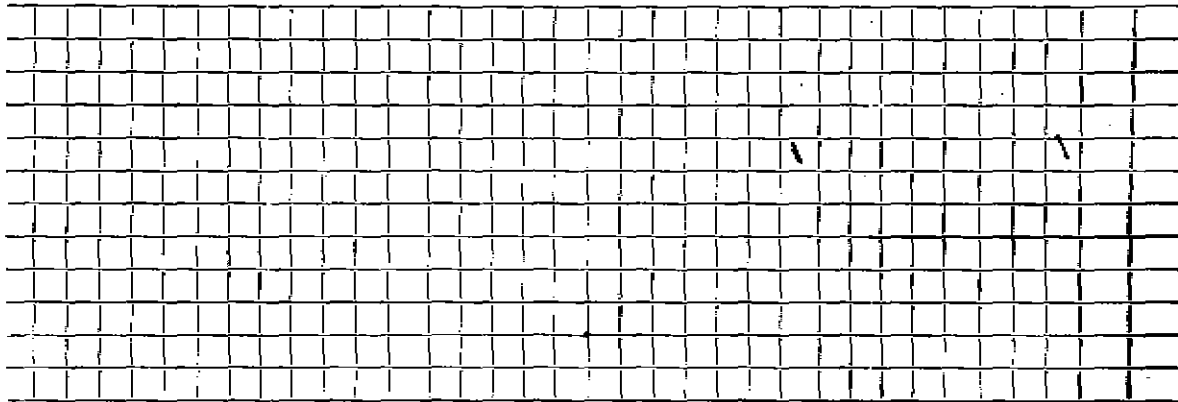

Connection made in ..... Street.

Work completed ..... 19..

Remarks: