

Name Robert Merriam

Service No. 27 229

Address ~~4 Oakmount Circle~~

12 Merriam St.

Location 12 Merriam St.,

Kind of Pipe

Size

Size of Main

Repair—Renewal—New Service

Location

Date 1936	Material	Amount	Total	Date	Amount
Dec. 9	28 hrs. @ 60¢	16 80		Feb. 5, 1937	64 73
<i>Com 17-22-36</i>	49½ " @ 55¢	27 23	44 03	<i>Paid</i>	
	10% Overhead		4 40		
			48 43		
	26' 6" Sewer Pipe @ 20¢		5 20		
	1 6 x 4 Reducer		60		
	Joint. Compound		1 50		
	Trucking		2 00		
	Compressor-2 hrs @ \$3.50		7 00		
11-29-79	<i>Repair.</i>		64 73		
	2' 6" Transite			3/22/73	<i>solids trap &amp; grease</i>
	1 6" x 2' Nipple			7-10-78	<i>grease, rags</i>
	1 Labor 6" Male C.T Adapter				

TOWN OF LEXINGTON—BOARD OF PUBLIC WORKS

SEWER DIVISION

DATE Dec 3 1936

NO. \_\_\_\_\_


The undersigned applies for the construction of a particular sewer connecting No. 12 Merriam Street and hereby agrees to comply with the Rules and Regulations governing the construction and use of Particular Sewers, as now or at any future time established by the Board of Selectmen.

Am't. of Estimate \$ \_\_\_\_\_

Am't. Paid \$ \_\_\_\_\_

Robert C Merriam Owner  
W 9 3

Sketch of Service Here

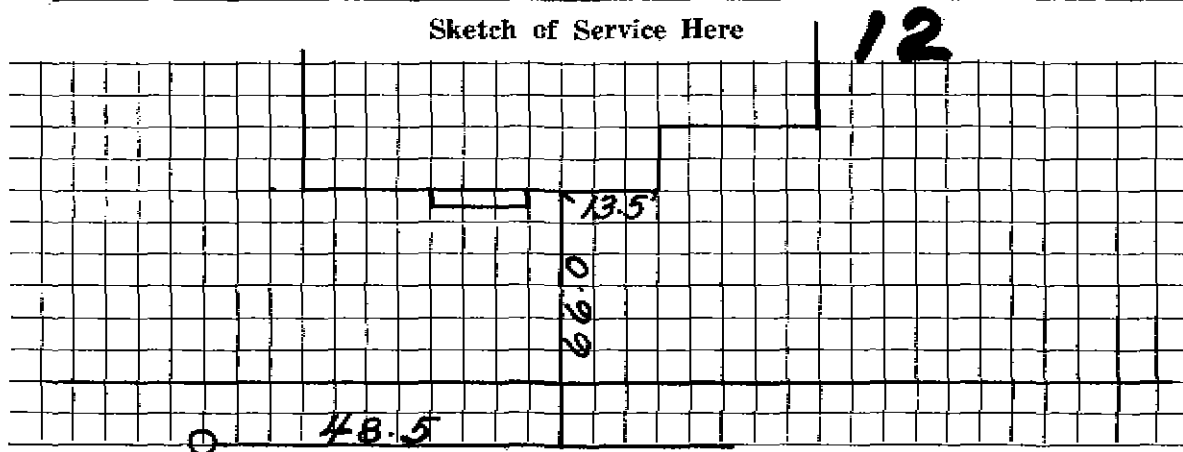

Connection made in \_\_\_\_\_ Street.

Work completed \_\_\_\_\_ 19

Remarks: