

15 Merriman Street

Location 51 Lincoln Street

Kind of Pipe

Size

Size of Main

Repair—Renewal—New Service

Location

Date	Material	Amount	Total	Date	Amount
April 3, 1939	Labor:			March 29, 1939	Deposited 125.00
5-11-39	24 hrs. @ 50¢	12 00		May 9, 1939	Paid 153.92
	92 " 55¢	50 60			178.92
	72 " 60¢	43 20			
	18 " 70¢	8 40			
	4 " 1.00	4 00	118 20		
	10% Overhead		11 92		
	56' 6" Sewer Pipe @ 20¢		11 20		
	1 6" 1/8 Bend		65		
	Joint, Compound		3 56		
	5 sticks Dynamite @ .08		40		
	10 exploders @ .08		80	Bill sent 4/6/39.	
	Compressor, 4 hrs. @ 3.00		12 00		
	Trucking, 6 hrs. @ .75		4 50		
			162 93	Miss. Amounts will pay bal.	
	Trench Repairs		15 99	in May	
	Labor		\$ 178 92	11-53-78 Reats	

Hedley Bros. Inc., Lexington

178.92  
125.00  
53.92

**TOWN OF LEXINGTON—BOARD OF PUBLIC WORKS**  
**SEWER DIVISION**

DATE \_\_\_\_\_

NO. \_\_\_\_\_


The undersigned applies for the construction of a particular sewer connecting No. 31 Lincoln Street Street and hereby agrees to comply with the Rules and Regulations governing the construction and use of Particular Sewers, as now or at any future time established by the Board of Selectmen.

Am't. of Estimate \$ 125.00 It is agreed that the Town of Lexington will not be responsible for any damages to the property while blasting.

Am't. Paid \$ 125.00

\_\_\_\_\_  
*Mrs. M. Simonds* Owner

Sketch of Service Here

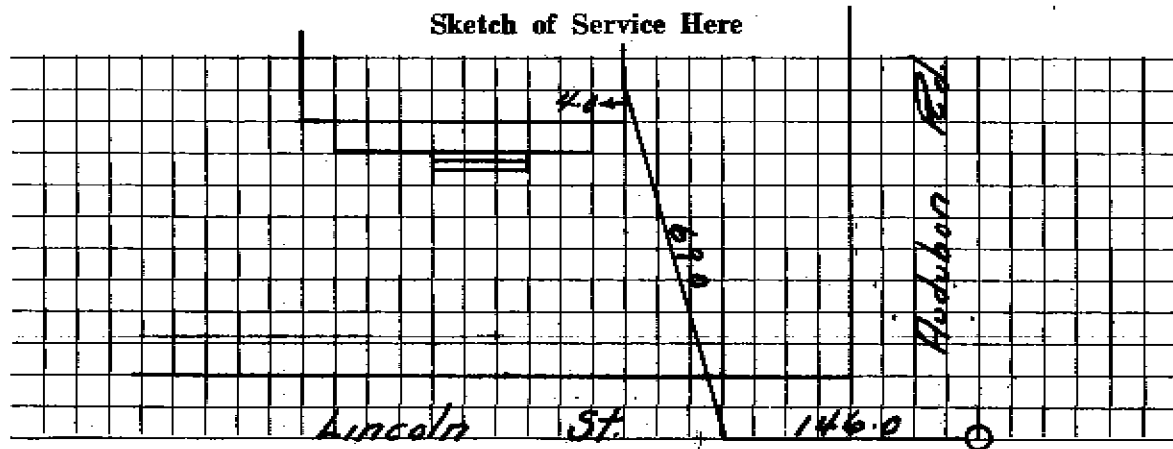

Connection made in \_\_\_\_\_ Street.

Work completed \_\_\_\_\_ 19

Remarks: