

Name Samuel Parker

Service No. 90

Address 18 Merriam Street

Lexington, Mass.

Location 18 Meriam ST.

Kind of Pipe

Size

Size of Main

Repair ~~Renewal~~ New Service

Location

Date	Material	Amount	Total	Date	Amount
10/ Aug. 6, '48	Labor	68 60	68 60	July 30 '48	18 00
	10% Overhead		6 86		
	74'-6" Sewer Pipe @ .26		19 24		
	Joint Compound		4 44		
	3 hrs. Littlefield Shovel		21 00		
	1 hr. Leader		3 00		
	2 hrs. Trucking		1 50		
	Patching 25 x 3		25 00		
			149 64		
	Labor				

Name **Samuel Parker**

Service No. 90

Address **18 Merriam Street**

Lexington, Mass.

Location **18 Meriam ST.**

Kind of Pipe

Size

Size of Main

~~Repair~~ ~~Renewal~~ **New Service**

Location

Date	Material	Amount	Total	Date	Amount
g.6, '48	Labor	68 60	68 60	July 30 '48	Reported
	10% Overhead		6 86		
	74' - 6" Sewer Pipe @ .26		19 24		
	Joint Compound		4 44		
	3 hrs. Littlefield Shovel		21 00		
	1 hr. Leader		3 00		
	2 hrs. Trucking		1 50		
	Patching 25 x 3		25 00		
			149 64		
	Labor				


DATE _____

TOWN OF LEXINGTON — BOARD OF PUBLIC WORKS

SEWER DIVISION

Sketch of Service Here

19

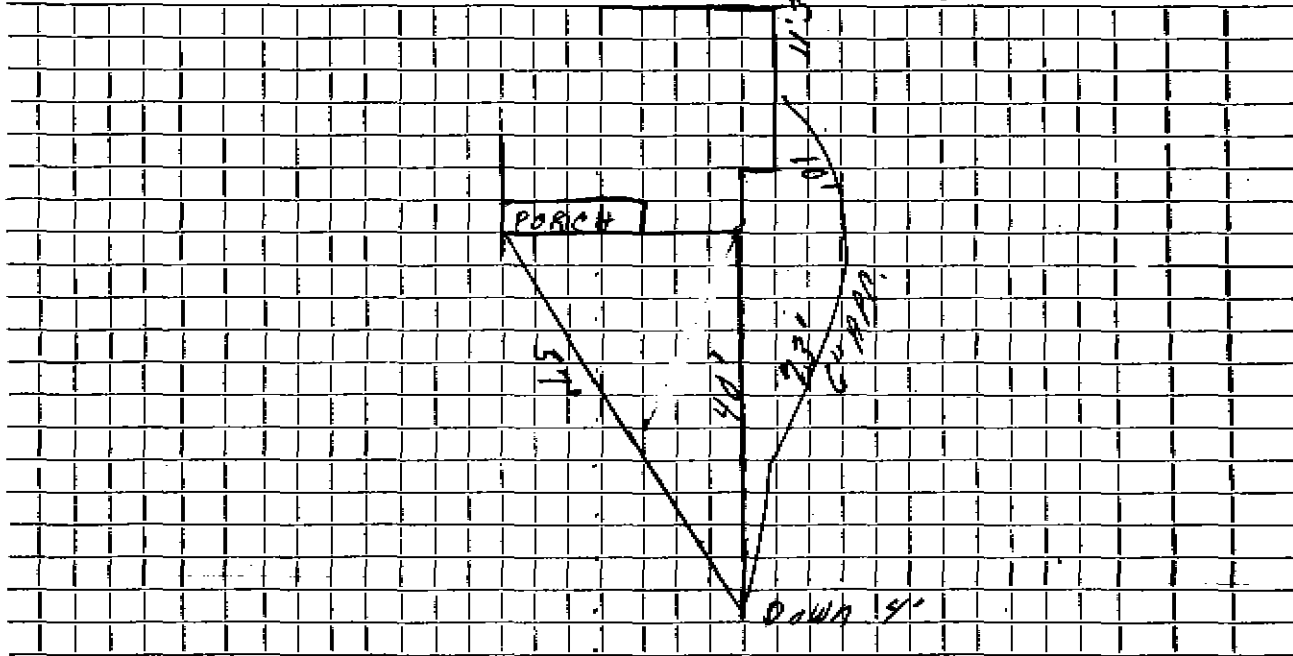

Connection made in Street. Work completed

Remarks:
.....
.....