

Name St. Nicholas Greek Orthodox Church

Service No. 59

Address 19 Meriam Street

19 Meriam ST.

Location

Kind of Pipe

Size

Size of Main

~~REPAIRS~~ - New Service Eagle #3460 W.O. #710

Location DEC 3 1979

Date	Material	Amount	Total	Date	Amount
9/10/79	Labor	158.58		8-27-79	375.00
	10% O.H.	15.86	174.44	12-14-79	52.47
4	5' Nipple @ 2.45		9.80		TOTAL
1	3' Nipple		12.64		
1	6" Nipple		1.93		
1	22 $\frac{1}{2}$ ^o Transite Elbow		4.34		
1	30 ^o Transite Elbow		5.97		
1	11 $\frac{1}{2}$ ^o Transite Band		9.52		
1	6" Plug		2.95		
6	Ton Gravel @1.50		9.00		
3	hrs. Trucking @3.00		9.00		
4	hrs. Town Shovel @6.50		26.00		
	Hot Top Street 20' x 8'		106.68		
	Hot Top Sidewalk 4' x 6'		16.00		
9/17/79	73' 6" Transite Pipe		427.47		
	10' 4" Cast Iron Pipe				


DATE _____

TOWN OF LEXINGTON — BOARD OF PUBLIC WORKS

SEWER DIVISION

Sketch of Service Here

19

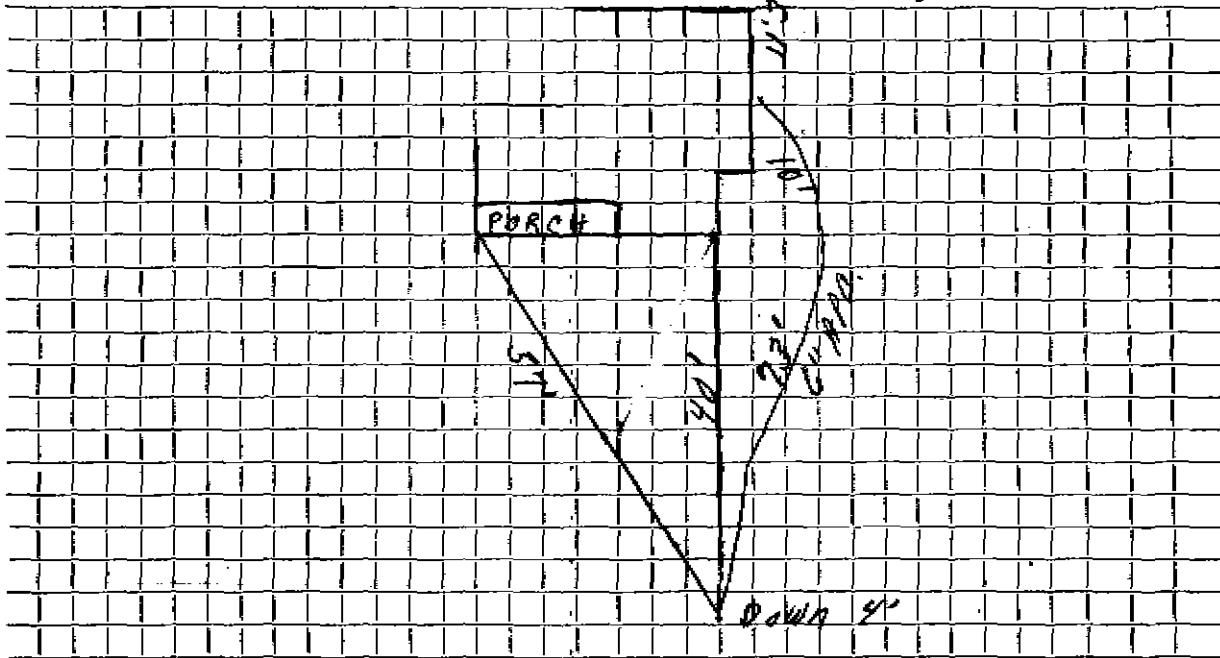

Connection made in Street. Work completed

Remarks:

.....

.....