

Name Harvey Neugent

Service No. 11 1024

Address 31 Meriam Street

Lexington, Mass.

Location 31 Meriam Street

Kind of Pipe

Size

Size of Main

~~Repair Break~~—New Service

Case 12-9-46

Location

Date	Material	Amount	Total	Date	Amount
June 19, '46	Labor	25 65		June 1 '46	16000
20	"	51 80	77 45	Dec 1 '46	2794
	10% Overhead		7 75		132 06
	66' - 6" Sewer Pipe @.256		16 90		
	Joint Compound		3 96		
	Patching 21' x 3'		21 00		
	Compressor 2 hrs. @1.75		3 50		
	Trucking 2 hrs. @.75		1 50		
			132 06		
	Labor				

TOWN OF LEXINGTON—DEPT. OF PUBLIC WORKS

SEWER DIVISION

DATE


NO.

The undersigned applies for the construction of a particular sewer connecting No. Street and hereby agrees to comply with the Rules and Regulations governing the construction and use of Particular Sewers, as now or at any future time established by the Board of Selectmen.

Am't of estimate \$.....

Am't Paid \$.....

..... Owner

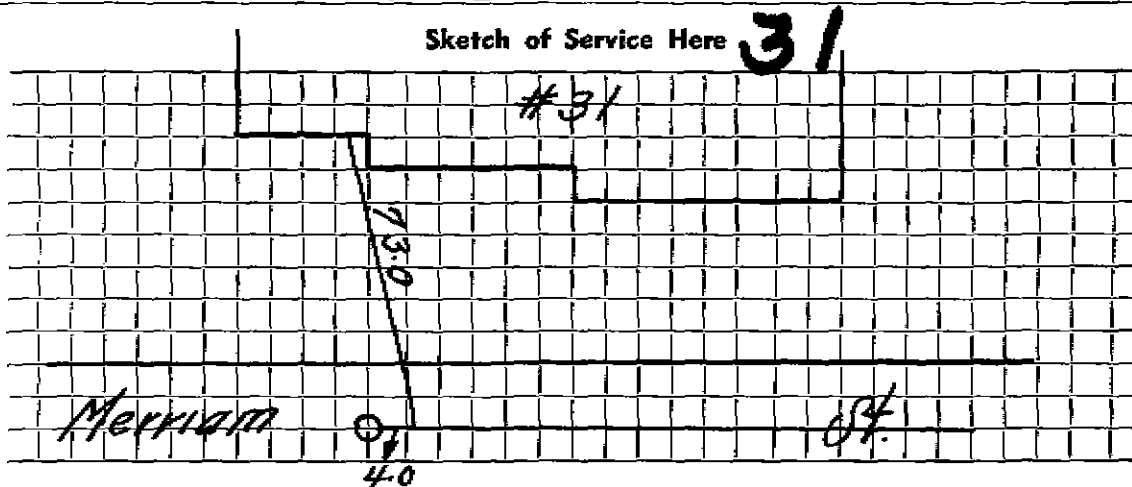

Connection made in Street.

Work completed 19..

Remarks: