

Name William Barnes

Service No. 18

Address 38 Meriam St.

38 Meriam ST.

Location

Kind of Pipe

Size 6"

Size of Main 8"

~~Revised~~ New Service WO#4260 Kel-Scott #2820

Location AUG 16 1976

Date	Material	Amount	Total	Date	Amount
4/2/76	Labor	154. 00		4/16/76	Deposit 500. 00
6/11/76	Labor	28. 84		8/16/76	Refund 192. 32
	10%OH	1. 83	184. 67	4-2-76	307. 68
	<del>30' 6" transit pipe @</del>	<del>1.48</del>	<del>44. 40</del>		30' 6" Transite
	<del>1 3" nipple</del>		<del>8. 26</del>		1 6" X 3' Nipple
	<del>1 6" nipple</del>		<del>1. 71</del>		1 6" X 6" Nipple
	<del>1 5' nipple @ 1.56</del>		<del>7. 80</del>		1 6" X 5' Nipple
	<del>1 90 degree Elbow</del>		<del>5. 48</del>		1 6"-90° Elbow
	<del>1 8 X 6 Saddle</del>		<del>14. 70</del>		1 6" X 8" Saddle
	<del>1 6" Plug</del>		<del>3. 75</del>		
	1/2 bag cement		1. 63		
	2 dozen red bricks @ .12		2. 88		
	2 tons cold patch @ 13.70		27. 40		
	1hr. truck @ 3.00		3. 00		
	1hr. loader @ 4.00		2. 00		
5/11/76	25' 6" Transite pipe		307. 68		
	10' 4" Cast Iron pipe				


DATE \_\_\_\_\_

TOWN OF LEXINGTON — BOARD OF PUBLIC WORKS

SEWER DIVISION

Sketch of Service Here

38

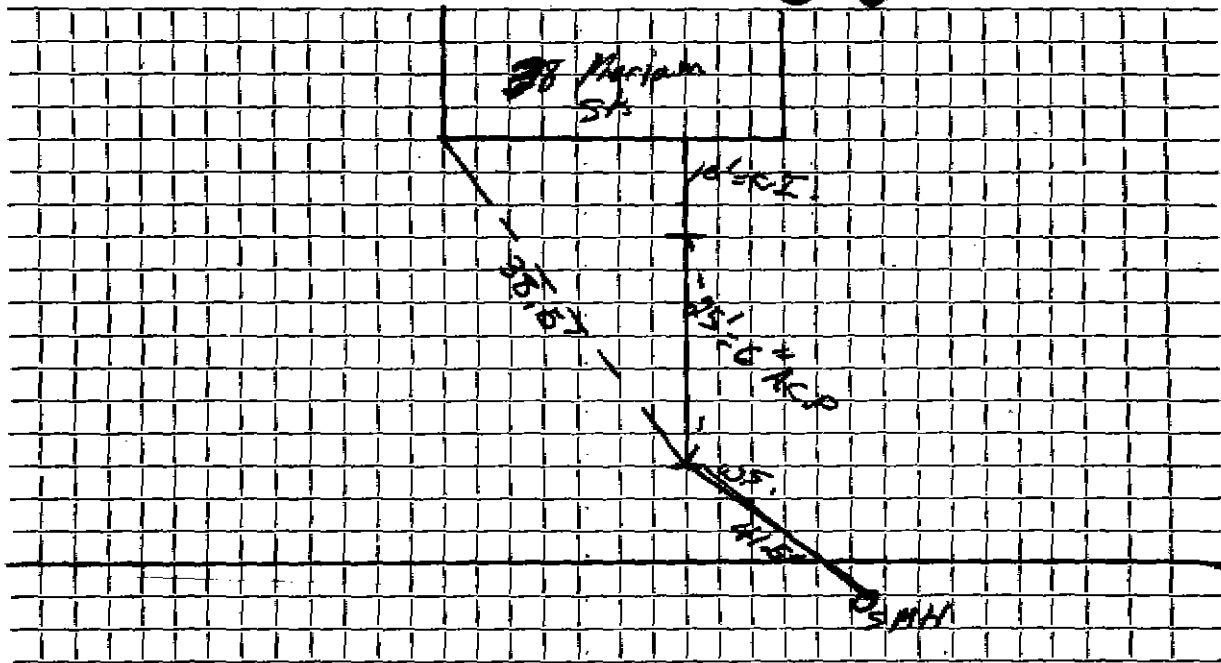

Connection made in 30 Meriam St. Street.

Work completed 5/11/76

Remarks: .....