

Name James L. Barrington

Service No. 28 737

Address ~~Hotel Sheraton, Boston,~~

#39 Merriam St.

Location

#39 Merriam Street

Kind of Pipe

Size

Size of Main

~~Repair - Renewed~~ - New Service

Location

Date 1938	Material	Amount	Total	Date	Amount
12/21/38	27 1/2 hrs. @ 50¢	13 75		November 28, 1938	165 00
<i>Conr 6-39</i>	206 " @ 55¢	113 30		Month 7, 1939	127 96
	65 1/2 " @ 60¢	39 30			292 96
	8 3/4 " @ 65¢	5 53			
	35 3/4 " @ 70¢	24 85	196 73 ✓		
	10% Overhead		19 67 ✓		
	84' 6" Sewer Pipe @ 20¢		16 80 ✓		
	10' 4" Soil Pipe @ 50¢		5 00 ✓		
	Jointing Compound		4.56 ✓		
	2100 lbs. #2 Gravel		95		
	9 hrs. Compressor @ 3.00		27.00		
	2 " trucking @ .75		1 50 ✓		
	Trench repairs		20 75 ✓		
			292 96		
	Labor				

Deposited
Paid

Bill sent 2-9-39

292.96
165.00
127.96

Hadley Press, Inc., Lexington

TOWN OF LEXINGTON—BOARD OF PUBLIC WORKS

SEWER DIVISION

DATE May 16, 1938

Car NO. _____

The undersigned applies for the construction of a particular sewer connecting No. Merriam St + Abbott Rd. Street and hereby agrees to comply with the Rules and Regulations governing the construction and use of Particular Sewers, as now or at any future time established by the Board of Selectmen. # 34 Merriam St

Am't. of Estimate \$ 165⁰⁰

Am't. Paid \$ _____


J. L. Barrington
Hotel Sherraton

Owner

Res. J. Barrington & Son

Sketch of Service Here

509 Maple St. N. Lond.

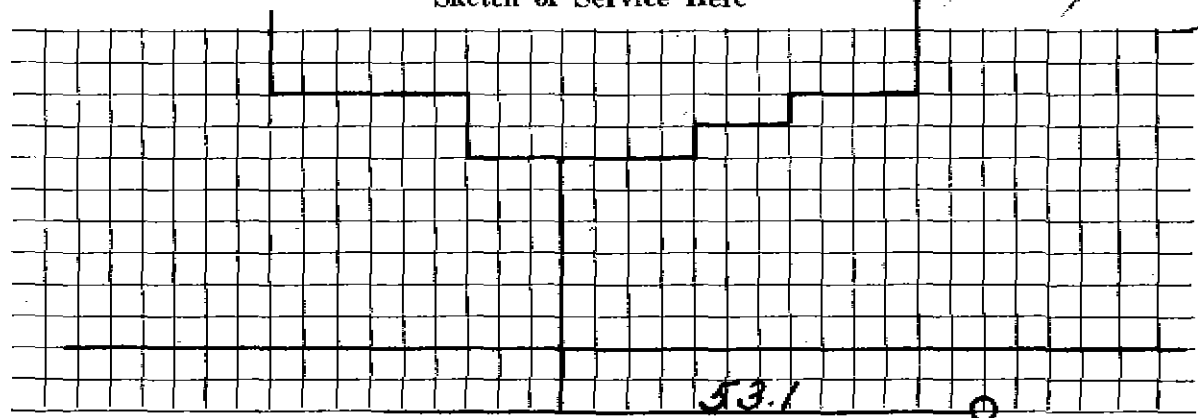

53.1

Connection made in _____ Street. Work completed _____ 19

Remarks: