

Name **Walter Black**Service No. **93**Address **40 Merriam Street****Lexington, Mass.**Location **40 Meriam ST.**

Kind of Pipe

Size

Size of Main

~~Repair~~ ~~Renewal~~ **New Service**

Location

Date	Material	Amount.	Total	Date	Amount
10, 1948	Labor	2 10	2 10	Aug 6 '48	150 00
11 "	"	41 33	41 33	Dec. 31 '48	19 49
	10% Overhead		4 34		180 51
	82' - 6" Sewer Pipe @ .26		21 32		
	Joint Compound		4 92		
	2 hrs. Littlefield Shovel		14 00	5-3-99 Contractor Brooke service	
	2 hrs. Allis Chalmers Tractor		6 00	repair made 4 1/2' 6" PVC	
	2 hrs. Trucking		1 50	2 - 6x6 4x4 PVC frames	
	Patching 35 x 3		35 00		
			130 51		
	Labor			1-29-65	ROOTS

TOWN OF LEXINGTON—DEPT. OF PUBLIC WORKS

SEWER DIVISION

DATE


NO.

The undersigned applies for the construction of a particular sewer connecting No.
Street and hereby agrees to comply with the Rules and Regulations governing the construction and use of Particular
Sewers, as now or at any future time established by the Board of Selectmen.

Am't of estimate \$.....

Am't Paid \$.....

..... Owner

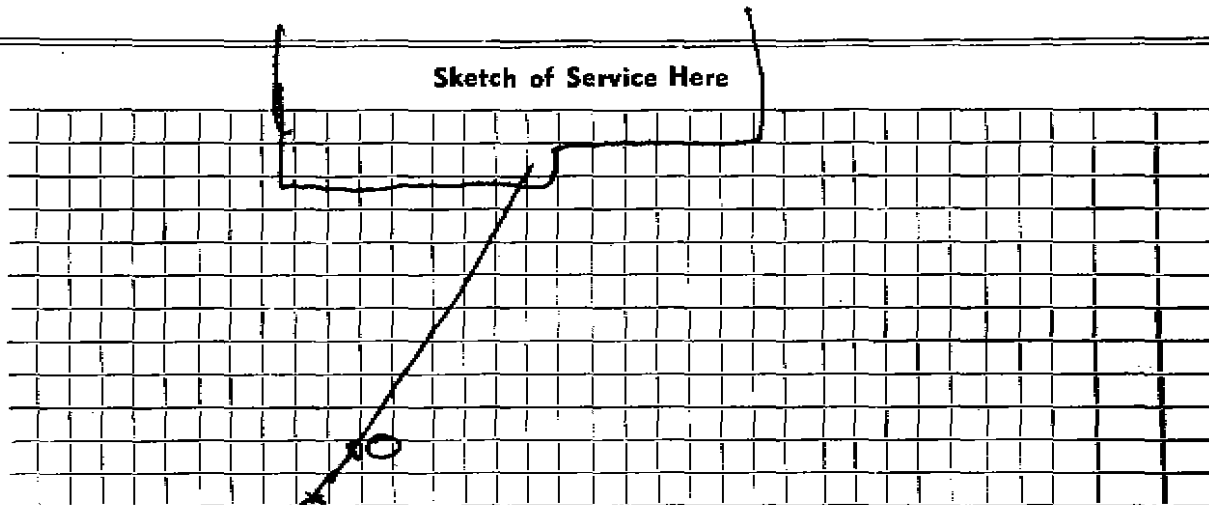

Connection made in Street. Work completed 19..

Remarks:

*Service is in same trench as water
Gas main is just outside of curb line*