

Name Leeland Const. Co., Inc.

Service No. 174 n.d.

Address 41 Merriam Street

41 Merriam ST.

Location

Kind of Pipe

Size

Size of Main

~~REPAIR RENEWAL~~ - New Service

COM. 12-31-54

Location

| Date | Material | Amount | Total | Date | Amount |
|----------|----------------------------|--------|-----------|-------------|---|
| 11/23/54 | Labor | 1 85 | | | |
| | 10% overhead | 19 | 2 04 | | |
| | 1/2' - 6" sewer pipe @ .32 | | 1 28 | | |
| | 1 - 6" Y | | 1 28 | | |
| | | | 4 60 | | |
| | TRENCH DUG BY OWNER: | | | | |
| 3/23/00 | REPAIR INSIDE OF ROAD | | 6" 4" PVC | 6" 2 FEMUCO | |
| | | | | 12-17-73 | Water in of line from service easement to Abbott Rd |
| | Labor | | | 8-16-99 | DO NOT RESPOND + MEASURE |
| | | | | 3-17-99 | Reading 84' our problem RESPOND HOWEVER |

No deposit
Paid

12-31-54

4 60

TOWN OF LEXINGTON—DEPT. OF PUBLIC WORKS
SEWER DIVISION

DATE

NO.


The undersigned applies for the construction of a particular sewer connecting No.
Street and hereby agrees to comply with the Rules and Regulations governing the construction and use of Particular
Sewers, as now or at any future time established by the Board of Selectmen.

Am't of estimate \$.....

Am't Paid \$.....

..... Owner

Sketch of Service Here

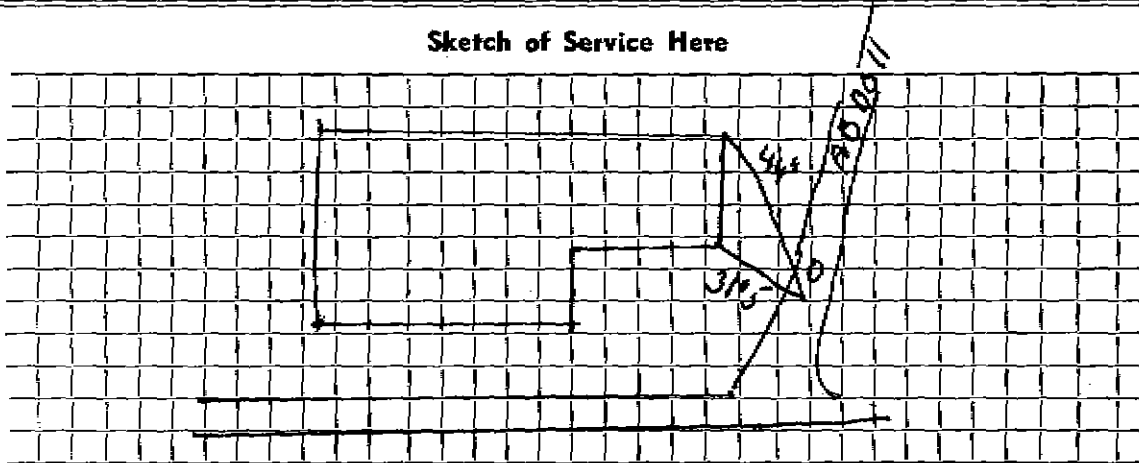

Connection made in *Service appears* Street.

Work completed 19..

Remarks: *to share line with G ABBOTT*